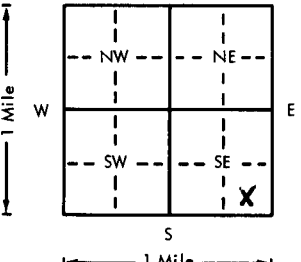
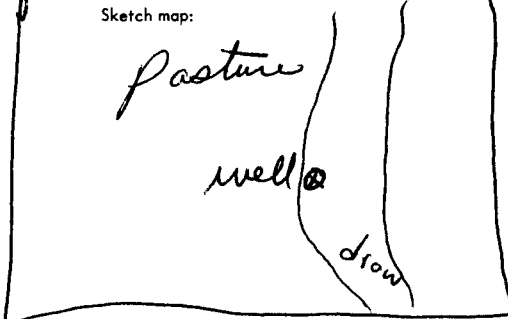


USE TYPEWRITER OR BALL  
POINT PEN-PRESS FIRMLY,  
PRINT CLEARLY.

WATER WELL RECORD  
KSA 82a-1201-1215

Kansas Department of Health and  
Environment-Division of Environment  
(Water well Contractors)  
Topeka, Kansas 66620

1. Location of well:		County <b>Jewell</b>	Fraction <b>C 3/4 SE 1/4 SE 1/4</b> <b>NW 1/4 SE 1/4 SE 1/4</b>	Section number <b>7</b>	Township number <b>T 3 S</b>	Range number <b>R 9 E 2</b>
2. Distance and direction from nearest town or city: Street address of well location if in city:		<b>3 E 3/4 S</b> <b>of Esbon KS</b>		3. Owner of well: <b>Gary Garmen</b> R.R. or street: <b>Burr oak KS. 66936</b> City, state, zip code:		
4. Locate with "X" in section below:		Sketch map:		6. Bore hole dia. <b>8</b> in. Completion date <b>6-23-77</b> Well depth <b>20</b> ft.		
				7. Cable tool <input checked="" type="checkbox"/> Rotary <input type="checkbox"/> Driven <input type="checkbox"/> Dug Hollow rod <input type="checkbox"/> Jetted <input type="checkbox"/> Bored <input type="checkbox"/> Reverse rotary		
5. Type and color of material		From		To		8. Use: Domestic <input type="checkbox"/> Public supply <input type="checkbox"/> Industry <input type="checkbox"/> Irrigation <input type="checkbox"/> Air conditioning <input checked="" type="checkbox"/> Stock <input type="checkbox"/> Lawn <input type="checkbox"/> Oil field water <input type="checkbox"/> Other <input type="checkbox"/>
top soil & clay		0		5		9. Casing: Material <b>pvc</b> Height: Above or below Threaded <input type="checkbox"/> Welded <input type="checkbox"/> Surface <b>24</b> in. RMP <input type="checkbox"/> PVC <input type="checkbox"/> Weight <input type="checkbox"/> lbs./ft. Dia. <b>5</b> in. to <b>20</b> ft. depth Wall Thickness: inches or Dia. <input type="checkbox"/> in. to <input type="checkbox"/> ft. depth gage No. <b>180</b>
broken Rock & clay		5		15		10. Screen: Manufacturer's name <b>Crown Line</b> Type <b>Slotted Per</b> Dia. <b>5</b> Slot/gauge <b>1/8 30</b> Length <b>10</b> Set between <input type="checkbox"/> ft. and <input type="checkbox"/> ft. <b>7</b> ft. and <b>17</b> ft. Gravel pack? <b>yes</b> Size range of material <b>fine - 3/8</b>
shale		15		20		11. Static water level: <input type="checkbox"/> mo./day/yr. <b>7</b> ft. below land surface Date <b>6-23-77</b>
						12. Pumping level below land surfaces: <b>10</b> ft. after <b>1</b> hrs. pumping <b>10</b> g.p.m. ft. after <input type="checkbox"/> hrs. pumping <input type="checkbox"/> g.p.m. Estimated maximum yield <b>15+</b> g.p.m.
						13. Water sample submitted: <input type="checkbox"/> mo./day/yr. Yes <input checked="" type="checkbox"/> No <input type="checkbox"/> Date <input type="checkbox"/>
						14. Well head completion: <b>24</b> Pitless adapter <input type="checkbox"/> <b>24</b> inches above grade
						15. Well grouted? <b>yes</b> With: Neat cement <input checked="" type="checkbox"/> Bentonite <input type="checkbox"/> Concrete <input type="checkbox"/> Depth: From <b>0</b> ft. to <b>6</b> ft. mhc
						16. Nearest source of possible contamination: ft. <b>150</b> Direction <b>W</b> Type <b>ditch</b> Well disinfected upon completion? <input checked="" type="checkbox"/> Yes <input type="checkbox"/> No
						17. Pump: <input checked="" type="checkbox"/> Not installed Manufacturer's name <input type="checkbox"/> Model number <input type="checkbox"/> HP <input type="checkbox"/> Volts <input type="checkbox"/> Length of drop pipe <input type="checkbox"/> ft. capacity <input type="checkbox"/> g.p.m. Type: <input type="checkbox"/> Submersible <input type="checkbox"/> Turbine <input type="checkbox"/> Jet <input type="checkbox"/> Reciprocating <input type="checkbox"/> Centrifugal <input type="checkbox"/> Other
						(Use a second sheet if needed)
18. Elevation:		19. Remarks:		20. Water well contractor's certification: This well was drilled under my jurisdiction and this report is true to the best of my knowledge and belief. <b>Maruhn Well Drilling 165</b> Business name <b>Red Cloud Ne</b> License No. <input type="checkbox"/> Address <b>Jessy Maruhn</b> Date <b>7-9-77</b> Signed <b>Jessy Maruhn</b> Authorized representative		
Topography: <input type="checkbox"/> Hill <input type="checkbox"/> Slope <input type="checkbox"/> Upland <input checked="" type="checkbox"/> Valley						