

**WATER WELL PLUGGING RECORD Form WWC-5P**

KSA 82a-1212

ID NO.


20049043

**1 LOCATION OF WATER WELL:**  
 County: REPUBLIC Fraction SE 1/4 SW 1/4 NE 1/4 Section Number 16 Township Number 4 Range Number 1 E/W

Distance and direction from nearest town or city street address of well if located within city?

RW-2

**2 WATER WELL OWNER:** BOETTCHER INTERESTS Global Positioning Systems (decimal degrees, min. of 4 digits)  
 RR#, St. Address, Box #: P.O. Box 486  
 City, State ZIP Code: BELOIT, KS 67420  
 Latitude: \_\_\_\_\_  
 Longitude: \_\_\_\_\_  
 Elevation: \_\_\_\_\_  
 Datum: \_\_\_\_\_  
 Data Collection Method: \_\_\_\_\_

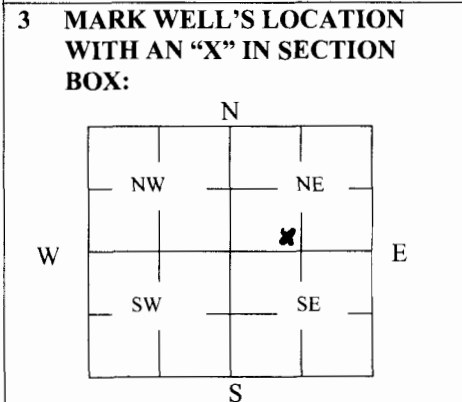

**4 DEPTH OF WELL** 64 ft.  
 WELL'S STATIC WATER LEVEL \_\_\_\_\_ ft.  
 WELL WAS USED AS:  
 1 Domestic                      5 Public Water Supply                      9 Dewatering  
 2 Irrigation                      6 Oil Field Water Supply                      10 Monitoring  
 3 Feedlot                          7 Domestic (Lawn & Garden)                      11 Injection Well  
 4 Industrial                      8 Air Conditioning                          12 Other RECOVERY  
 Was a chemical/bacteriological sample submitted to Department? Yes \_\_\_\_\_ No X

**5 TYPE OF BLANK CASING USED:**  
 1 Steel      3 RMP (SR)      5 Wrought      7 Fiberglass      9 Other (Specify below)  
 2 PVC      4 ABS      6 Asbestos-Cement      8 Concrete Tile  
 Blank casing diameter 5 in. Was casing pulled? Yes \_\_\_\_\_ No X If yes, how much \_\_\_\_\_  
 Casing height above or below land surface 24 in.

**6 GROUT PLUG MATERIAL:**      1 Neat cement      2 Cement grout      3 Bentonite      4 Other \_\_\_\_\_  
 Grout Plug Intervals: From 0 ft. to 64 ft., From \_\_\_\_\_ ft. to \_\_\_\_\_ ft., From \_\_\_\_\_ to \_\_\_\_\_ ft.  
 What is the nearest source of possible contamination:  
 1 Septic tank      6 Seepage pit      11 Fuel Storage      16 Other (specify below) NONE APPARENT  
 2 Sewer lines      7 Pit privy      12 Fertilizer storage  
 3 Watertight sewer lines      8 Sewage lagoon      13 Insecticide storage  
 4 Lateral lines      9 Feedyard      14 Abandoned water well      Direction from well? \_\_\_\_\_  
 5 Cess pool      10 Livestock pens      15 Oil well/Gas well      How many feet? \_\_\_\_\_

FROM	TO	PLUGGING MATERIALS	FROM	TO	PLUGGING MATERIALS
<u>0</u>	<u>64</u>	<u>BENTONITE HOLE PLUG</u>			

**7 CONTRACTOR'S OR LANDOWNER'S CERTIFICATION:** This water well was plugged under my jurisdiction and was completed on (mo/day/year) 12-11-15 and this record is true to the best of my knowledge and belief. Kansas Water Well Contractor's License No. 388. This Water Well Record was completed on (mo/day/year) 12-12-15 under the business name of PESTINGER PUMP SERVICE by (signature) Jeff Pesty

**INSTRUCTIONS:** Use typewriter or ballpoint pen. Please press firmly and print clearly. Please fill in blanks, underline or circle the correct answers. Send top three copies to Kansas Department of Health and Environment, Bureau of Water, Geology Section, 1000 SW Jackson St., Ste. 420, Topeka, Kansas 66612-1367. Telephone: 785/296-5522. Send one to Water Well Owner and retain one for your records. Visit us at <http://www.kdheks.gov/geo/waterwells>.