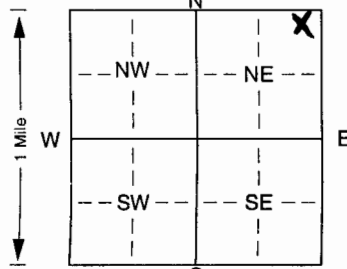


1 LOCATION OF WATER WELL: Fraction NE 1/4 NE 1/4 NE 1/4 Section Number 23 Township Number T 4 S Range Number R 11
 County: Smith

Distance and direction from nearest town or city street address of well if located within city?
LEBANON, KANSAS - 7 miles South - 1 3/4 miles East

2 WATER WELL OWNER: IVAN MANSHOLT
 RR#, St. Address, Box #: RR 2, BOX 96 Board of Agriculture, Division of Water Resources
 City, State, ZIP Code: LEBANON, KS 66952 Application Number:

3 LOCATE WELL'S LOCATION WITH AN "X" IN SECTION BOX:

 4 DEPTH OF COMPLETED WELL: 44 ft. ELEVATION:
 Depth(s) Groundwater Encountered 1. 18 ft. 2. 40 ft. 3. 2 ft.
 WELL'S STATIC WATER LEVEL 18 ft. below land surface measured on mo/day/yr
 Pump test data: Well water was 40 ft. after 2 hours pumping 7 gpm
 Est. Yield 7 gpm; Well water was 44 ft. after 2 hours pumping 7 gpm
 Bore Hole Diameter: 10 in. to 44 ft., and 44 in. to 44 ft.
 WELL WATER TO BE USED AS:
 5 Public water supply 8 Air conditioning 11 Injection well
 1 Domestic 3 Feedlot 6 Oil field water supply 9 Dewatering 12 Other (Specify below)
 2 Irrigation 4 Industrial 7 Domestic (lawn & garden) 10 Monitoring well LIVESTOCK
 Was a chemical/bacteriological sample submitted to Department? Yes No
 Water Well Disinfected? Yes No

5 TYPE OF BLANK CASING USED:
 1 Steel 3 RMP (SR) 5 Wrought iron 8 Concrete tile CASING JOINTS: Glued Clamped
 2 PVC 4 ABS 7 Fiberglass 9 Other (specify below) Welded
 Blank casing diameter 4 1/2 in. to 24 ft., Dia 24 in. to 44 ft., Dia 40 in. to 44 ft.
 Casing height above land surface 24 in., weight 34 lbs./ft. Wall thickness or gauge No. 40
 TYPE OF SCREEN OR PERFORATION MATERIAL:
 1 Steel 3 Stainless steel 5 Fiberglass 8 RMP (SR) 10 Asbestos-cement
 2 Brass 4 Galvanized steel 6 Concrete tile 9 ABS 11 Other (specify)
 12 None used (open hole)
 SCREEN OR PERFORATION OPENINGS ARE:
 1 Continuous slot 3 Mill slot 5 Gauzed wrapped 8 Saw cut 11 None (open hole)
 2 Louvered shutter 4 Key punched 6 Wire wrapped 9 Drilled holes
 7 Torch cut 10 Other (specify) 44 ft.
 SCREEN-PERFORATED INTERVALS: From 24 ft. to 44 ft., From 21 ft. to 44 ft.
 GRAVEL PACK INTERVALS: From 0 ft. to 2 ft., From 21 ft. to 44 ft.

6 GROUT MATERIAL: 1 Neat cement 2 Cement grout 3 Bentonite 4 Other
 Grout Intervals: From 2 ft. to 21 ft., From 21 ft. to 44 ft.
 What is the nearest source of possible contamination:
 1 Septic tank 4 Lateral lines 7 Pit privy 10 Livestock pens 14 Abandoned water well
 2 Sewer lines 5 Cess pool 8 Sewage lagoon 11 Fuel storage 15 Oil well/Gas well
 3 Watertight sewer lines 6 Seepage pit 9 Feedyard 12 Fertilizer storage 16 Other (specify below)
NONE
 Direction from well? How many feet?

FROM	TO	LITHOLOGIC LOG	FROM	TO	PLUGGING INTERVALS
0	15	Topsoil into Clay			
15	25	COBBLESTONE w/ THIN CLAY STRIP			
25	42	Blue Mud w/ THIN COBBLESTONE STRIPS			
42	44	Black Shale			

7 CONTRACTOR'S OR LANDOWNER'S CERTIFICATION: This water well was (1) constructed, (2) reconstructed, or (3) plugged under my jurisdiction and was completed on (mo/day/year) 8/3/2006 and this record is true to the best of my knowledge and belief. Kansas Water Well Contractor's Licence No. 433 This Water Well Record was completed on (mo/day/yr) 8/24/2006 under the business name of Chris Jergent Irrigation Co. INC by (signature) Randy E Mansholt