


1 LOCATION OF WATER WELL: County: Smith Fraction: NE 1/4 SW 1/4 SW 1/4 Section Number: 21 Township Number: T 4 S Range Number: R 13 E
 Distance and direction from nearest town or city street address of well if located within city?
3 1/4 S Smith Center KS

2 WATER WELL OWNER: SMITH Center County Club Inc
 RR#, St. Address, Box #: 120 E Court P.O. Box 265 Board of Agriculture, Division of Water Resources
 City, State, ZIP Code: SMITH Center KS 66967-0265 Application Number:

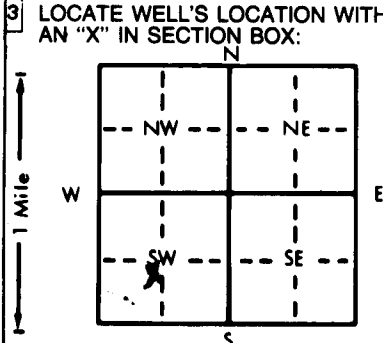

4 DEPTH OF COMPLETED WELL: 40 ft. ELEVATION: ft.
 Depth(s) Groundwater Encountered 1. 10 ft. 2. ft. 3. ft.
 WELL'S STATIC WATER LEVEL: 10 ft. below land surface measured on 11-23-88 mo/day/yr
 Pump test data: Well water was UNKNOWN ft. after air developed hours pumping gpm
 Est. Yield 35+ gpm: Well water was ft. after hours pumping gpm
 Bore Hole Diameter: 8 in. to 40 ft., and in. to ft.
 WELL WATER TO BE USED AS:
 1 Domestic 3 Feedlot 6 Oil field water supply 9 Dewatering 12 Other (Specify below)
 2 Irrigation 4 Industrial 7 Lawn and garden only 10 Observation well
 Was a chemical/bacteriological sample submitted to Department? Yes..... No X.....; If yes, mo/day/yr sample was submitted
 Water Well Disinfected? Yes No

5 TYPE OF BLANK CASING USED:
 1 Steel 3 RMP (SR) 5 Wrought iron 8 Concrete tile CASING JOINTS: Glued X Clamped
 2 PVC 4 ABS 6 Asbestos-Cement 9 Other (specify below) Welded
 Blank casing diameter 5 in. to 15 ft., Dia. in. to ft., Dia. in. to ft.
 Casing height above land surface 16 in., weight 229 cft lbs./ft. Wall thickness or gauge No. 214
 TYPE OF SCREEN OR PERFORATION MATERIAL:
 1 Steel 3 Stainless steel 5 Fiberglass 8 RMP (SR) 10 Asbestos-cement
 2 Brass 4 Galvanized steel 6 Concrete tile 9 ABS 11 Other (specify)
 SCREEN OR PERFORATION OPENINGS ARE:
 1 Continuous slot 3 Mill slot 5 Gauzed wrapped 8 Saw cut 11 None (open hole)
 2 Louvered shutter 4 Key punched 6 Wire wrapped 9 Drilled holes
 7 Torch cut 10 Other (specify)
 SCREEN-PERFORATED INTERVALS: From 15 ft. to 35 ft., From ft. to ft.
 GRAVEL PACK INTERVALS: From 10 ft. to 40 ft., From ft. to ft.

6 GROUT MATERIAL: 1 Neat cement 2 Cement grout 3 Bentonite 4 Other
 Grout intervals: From 0 ft. to 12 ft., From ft. to ft., From ft. to ft.
 What is the nearest source of possible contamination:
 1 Septic tank 4 Lateral lines 7 Pit privy 10 Livestock pens 14 Abandoned water well
 2 Sewer lines 5 Cess pool 8 Sewage lagoon 11 Fuel storage 15 Oil well/Gas well
 3 Watertight sewer lines 6 Seepage pit 9 Feedyard 12 Fertilizer storage 16 Other (specify below)
 13 Insecticide storage Creek
 Direction from well? S How many feet? 100

FROM	TO	LITHOLOGIC LOG	FROM	TO	LITHOLOGIC LOG
0	10	Top soil & clay			
10	20	Sand w/ clay & broken rock			
20	30	broken rock & sand w/ some clay			
30	35	large broken rock & sand			
35	45	Shale			

7 CONTRACTOR'S OR LANDOWNER'S CERTIFICATION: This water well was 1 constructed, (2) reconstructed, or (3) plugged under my jurisdiction and was completed on (mo/day/year) 11-23-88 and this record is true to the best of my knowledge and belief. Kansas Water Well Contractor's License No. 165 This Water Well Record was completed on (mo/day/yr) 11-23-88 under the business name of Maruhn well Drilling by (signature) LeRoy Maruhn