


USE TYPEWRITER OR BALL POINT PEN-PRESS FIRMLY, PRINT CLEARLY.

WATER WELL RECORD
KSA 82a-1201-1215

Kansas Department of Health and Environment-Division of Environment (Water well Contractors) Topeka, Kansas 66620

1. Location of well: County Smith Fraction NE 1/4 NW 1/4 SE 1/4 Section number 31 Township number T 4 S R 14 E/W Range number

2. Distance and direction from nearest town or city: 5 mile north of Cedar, Kan Street address of well location if in city:
3. Owner of well: VICTOR KIRKHOFFS R.R. or street:
City, state, zip code: Cedar, Kan 67628

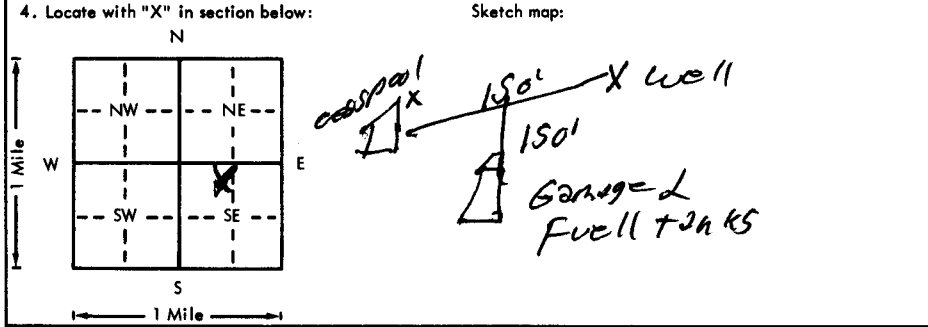

6. Bore hole dia. 9 in. Completion date 3-15-77
Well depth 51 ft.
7. Cable tool Rotary Driven Dug
 Hollow rod Jetted Bored Reverse rotary
8. Use: Domestic Public supply Industry
 Irrigation Air conditioning Stock
 Lawn Oil field water Other
9. Casing: Material plastic Height Above or below
Threaded Welded Surface 24 in. RMP PVC Weight 320 lbs./ft.
Dia. 6 in. to 51 ft. depth; Wall Thickness: inches or Dia. 6 in. to 51 ft. depth; gage No. 320-250 MNC

5. Type and color of material

	From	To
<u>Brown clay</u>	<u>0</u>	<u>23</u>
<u>Sand, med GRAVEL (Brown)</u>	<u>23</u>	<u>48</u>
<u>Hard Blue shale</u>	<u>48</u>	<u>51</u>

10. Screen: Manufacturer's name PVC PERSONALIZED WITH SKI SAW
Type PVC Dia. 6"
50 gauze 1/8" Length 17'
Set between 34 ft. and 51 ft.
Gravel pack? Size range of material 4/10 to 20
11. Static water level: 34 ft. below land surface Date 3-15-77 mo./day/yr.
12. Pumping level below land surfaces:
45 ft. after 2 hrs. pumping 135 g.p.m.
____ ft. after ____ hrs. pumping ____ g.p.m.
Estimated maximum yield 250 g.p.m.
13. Water sample submitted: ____ Yes No Date ____ mo./day/yr.
14. Well head completion: not done
 Pitless adapter ____ inches above grade
15. Well grouted? yes
With: Neat cement Bentonite Concrete
Depth: From 5 ft. to 15 ft.
16. Nearest source of possible contamination: 50 ft. SW Direction SW Type pond
Well disinfected upon completion? ____ Yes No
17. Pump: Not installed
Manufacturer's name ____ HP ____ Volts ____
Model number ____ Length of drop pipe ____ ft. capacity ____ g.p.m.
Type: Submersible Turbine
 Jet Reciprocating
 Centrifugal Other

18. Elevation: Topography: Hill Slope Upland Valley
19. Remarks:
20. Water well contractor's certification: This well was drilled under my jurisdiction and this report is true to the best of my knowledge and belief.
DLK Drilling Co 303 Business name License No. 411 City, Kan. Address
Signed Alford J. Morris Date 4-12-77 Authorized representative

T 4
R 14
E
S 1
NE NW SE
1/4 1/4 1/4