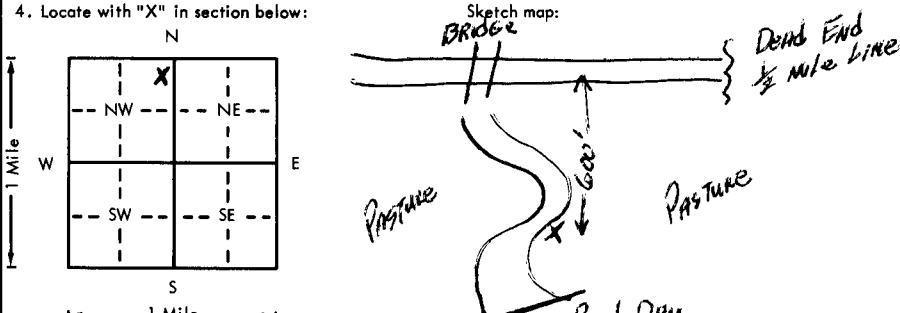


USE TYPEWRITER OR BALL POINT PEN-PRESS FIRMLY, PRINT CLEARLY.

WATER WELL RECORD
KSA 82a-1201-1215

Kansas Department of Health and Environment-
Division of Environment
(Water well Contractors)
Topeka, Kansas 66620

1. Location of well:		County Smith	Fraction NE 1/4 NE 1/4 NW 1/4	Section number 12	Township number T 4 S R 15	Range number E (W)
2. Distance and direction from nearest town or city: From south edge of Kensington, 2 miles south and 2 1/2 miles east on S. side of rd.				3. Owner of well: Milton Detwiler R.R. or street: Route 1 City, state, zip code: Kensington, Ks. 66951		
4. Locate with "X" in section below: 				6. Bore hole dia. 9 3/8 in. Completion date 3/27/77 Well depth 45 ft.		
5. Type and color of material				From	To	7. <input checked="" type="checkbox"/> Cable tool <input type="checkbox"/> Rotary <input type="checkbox"/> Driven <input type="checkbox"/> Dug <input type="checkbox"/> Hollow rod <input type="checkbox"/> Jetted <input type="checkbox"/> Bored <input type="checkbox"/> Reverse rotary
Top Soil				0	18	8. Use: <input type="checkbox"/> Domestic <input type="checkbox"/> Public supply <input type="checkbox"/> Industry <input type="checkbox"/> Irrigation <input type="checkbox"/> Air conditioning <input checked="" type="checkbox"/> Stock <input type="checkbox"/> Lawn <input type="checkbox"/> Oil field water <input type="checkbox"/> Other
Sandy Silt, Streaks of medium gravel				18	41	9. Casing: Material plastic Right: <input type="checkbox"/> Above or below Threaded <input type="checkbox"/> Welded <input checked="" type="checkbox"/> glue Surface 12 in. RMP <input type="checkbox"/> PVC <input checked="" type="checkbox"/> Weight 3.23 lbs./ft. Dia. 6 in. to 43 ft. depth Wall Thickness: inches or Dia. <input type="checkbox"/> in. to <input type="checkbox"/> ft. depth 100 .253
Shale				41	45	10. Screen: Manufacturer's name Robintech Type <input type="checkbox"/> Dia. 6" <input checked="" type="checkbox"/> Slot 1/32" Length 12' Set between 31 ft. and 43 ft. ft. and <input type="checkbox"/> ft. Gravel pack? <input checked="" type="checkbox"/> yes Size range of material 4" minus
						11. Static water level: _____ mo./day/yr. 27 ft. below land surface Date 3-27-77
						12. Pumping level below land surfaces: _____ ft. after _____ hrs. pumping _____ g.p.m. _____ ft. after _____ hrs. pumping _____ g.p.m. Estimated maximum yield 15 g.p.m.
						13. Water sample submitted: _____ mo./day/yr. Yes <input checked="" type="checkbox"/> No <input type="checkbox"/> Date _____
						14. Well head completion: <input type="checkbox"/> Pitless adapter 12 inches above grade
						15. Well grouted? <input checked="" type="checkbox"/> Yes With: <input type="checkbox"/> Neat cement <input checked="" type="checkbox"/> Bentonite <input type="checkbox"/> Concrete Depth: From 0 ft. to 12 ft.
						16. Nearest source of possible contamination: NONE ft. _____ Direction _____ Type _____ Well disinfected upon completion? _____ Yes _____ No
						17. Pump: <input checked="" type="checkbox"/> Not installed Manufacturer's name _____ Model number _____ HP _____ Volts _____ Length of drop pipe _____ ft. capacity _____ g.p.m. Type: <input type="checkbox"/> Submersible <input type="checkbox"/> Turbine <input type="checkbox"/> Jet <input type="checkbox"/> Reciprocating <input type="checkbox"/> Centrifugal <input type="checkbox"/> Other
(Use a second sheet if needed)						
18. Elevation:		19. Remarks:		20. Water well contractor's certification: This well was drilled under my jurisdiction and this report is true to the best of my knowledge and belief. Deer Drilling 344 Business name R.R.4 Phillipsburg Ks License No. _____ Address _____ Signed William J. Deer Date 3-30-77 Authorized representative		
Topography: <input type="checkbox"/> Hill <input checked="" type="checkbox"/> Slope <input checked="" type="checkbox"/> Upland <input type="checkbox"/> Valley						

T 4
 R 15
 E (W)
 Sec
 1/4 NE
 1/4 NW