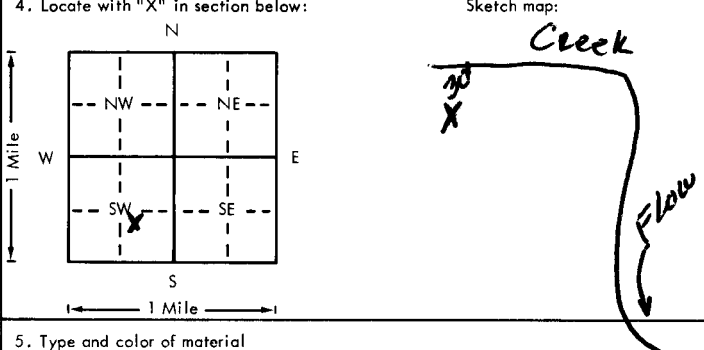


USE TYPEWRITER OR BALL POINT PEN-PRESS FIRMLY, PRINT CLEARLY.

WATER WELL RECORD  
KSA 82a-1201-1215

Kansas Department of Health and Environment-Division of Environment (Water well Contractors) Topeka, Kansas 66620

1. Location of well:	County <b>Smith</b>	Fraction <b>NW 1/4 SE 1/4 SW 1/4</b>	Section number <b>15</b>	Township number <b>T 4 S R 15</b>	Range number <b>15</b>	<b>W</b>
2. Distance and direction from nearest town or city: <b>From Claudell: 1 mi. East, 2 1/4 North and 1/2 East</b>			3. Owner of well: <b>Junior Cole</b> R.R. or street: <b>RR</b> City, state, zip code: <b>Kensington, Ks. 66951</b>			
4. Locate with "X" in section below: 			6. Bore hole dia. <b>9 1/2</b> in. Completion date _____ Well depth <b>35</b> ft. <b>8-18-79</b>			
5. Type and color of material			From	To	7. <input checked="" type="checkbox"/> Cable tool <input type="checkbox"/> Rotary <input type="checkbox"/> Driven <input type="checkbox"/> Dug <input type="checkbox"/> Hollow rod <input type="checkbox"/> Jetted <input type="checkbox"/> Bored <input type="checkbox"/> Reverse rotary	
<b>Top Soil</b>			<b>0</b>	<b>10</b>	8. Use: <input type="checkbox"/> Domestic <input type="checkbox"/> Public supply <input type="checkbox"/> Industry <input checked="" type="checkbox"/> Irrigation <input type="checkbox"/> Air conditioning <input type="checkbox"/> Stock <input type="checkbox"/> Lawn <input type="checkbox"/> Oil field water <input type="checkbox"/> Other	
<b>Brown Clay</b>			<b>10</b>	<b>15</b>	9. Casing: Material <b>Plastic</b> Height: Above or <del>xxx</del> Threaded <input type="checkbox"/> Welded <input type="checkbox"/> Surface <input type="checkbox"/> <b>30</b> in. RMP <input type="checkbox"/> PVC <input checked="" type="checkbox"/> Weight _____ lbs./ft. Dia. <b>6</b> in. to <b>35</b> ft. depth Wall Thickness: <b>Sch 40</b> Dia. _____ in. to _____ ft. depth Gage No. <del>Unknown</del>	
<b>Fine Sand &amp; silt</b>			<b>15</b>	<b>24</b>	10. Screen: Manufacturer's name <b>Western</b> Type <b>PVC</b> Dia. <b>6"</b> Slot/gauze <b>Unknown</b> Length <b>20'</b> Set between <b>35</b> ft. and <b>15</b> ft. _____ ft. and _____ ft.	
<b>Coarse Gravel</b>			<b>24</b>	<b>29</b>	Gravel pack? <b>yes</b> Size range of material: <b>1/4 minus</b>	
<b>Chalk Rock</b>			<b>29</b>	<b>30</b>	11. Static water level: _____ mo./day/yr. <b>16</b> ft. below land surface Date <b>8-18-79</b>	
<b>Shale</b>			<b>30</b>	<b>35</b>	12. Pumping level below land surfaces: _____ ft. after _____ hrs. pumping _____ g.p.m. _____ ft. after _____ hrs. pumping _____ g.p.m. Estimated maximum yield <b>70</b> g.p.m.	
					13. Water sample submitted: _____ mo./day/yr. <input type="checkbox"/> Yes <input checked="" type="checkbox"/> No Date _____	
					14. Well head completion: <input type="checkbox"/> Pitless adapter <b>30</b> Inches above grade	
					<input checked="" type="checkbox"/> Well grouted? <b>yes</b> With: _____ Neat cement _____ Bentonite _____ Concrete _____ Depth: From <b>0</b> ft. to <b>10</b> ft.	
					16. Nearest source of possible contamination: <b>None</b> ft. _____ Direction _____ Type _____ Well disinfected upon completion? <input type="checkbox"/> Yes <input checked="" type="checkbox"/> No	
					17. Pump: <input checked="" type="checkbox"/> Not installed Manufacturer's name _____ Model number _____ HP _____ Volts _____ Length of drop pipe _____ ft. capacity _____ g.p.m. Type: <input type="checkbox"/> Submersible <input type="checkbox"/> Turbine <input type="checkbox"/> Jet <input type="checkbox"/> Reciprocating <input type="checkbox"/> Centrifugal <input type="checkbox"/> Other	
			(Use a second sheet if needed)			
18. Elevation:		19. Remarks:		20. Water well contractor's certification: This well was drilled under my jurisdiction and this report is true to the best of my knowledge and belief. <b>Deer Drilling</b> <b>344</b> Business name License No. Address <b>Rt 4 Phillipsburg, Ka</b> Signed <b>William J. Deer</b> Date <b>8-23-79</b> Authorized representative		

T  
R  
W  
E  
S  
E  
S  
W  
1/4  
1/4  
1/4  
1/4