

USE TYPEWRITER OR BALL POINT PEN-PRESS FIRMLY, PRINT CLEARLY.


415W35N4SW
T R EW sec 1/4 1/4 1/4 No.

WATER WELL RECORD
KSA 82a-1201-1215

Kansas State Dept. Of Health
(Water Well Contractors)
Forbes-Bldg. 740
Topeka, Kansas 66620

1 Location of well:	County <u>Smith</u>	Township name <u>Valley</u>	Fraction <u>1/4 SW 1/4 Sec 35</u>	Section number <u>35</u>	Town number <u>4</u>	Range number <u>15</u>
---------------------	------------------------	--------------------------------	--------------------------------------	-----------------------------	-------------------------	---------------------------

Distance and direction from nearest town or city: 2 m East
 Street address of well location if in city: 715 Clauwell, Kan
 3 Owner of well: SWEET ACRES
 Address: CO. 300, Kansas

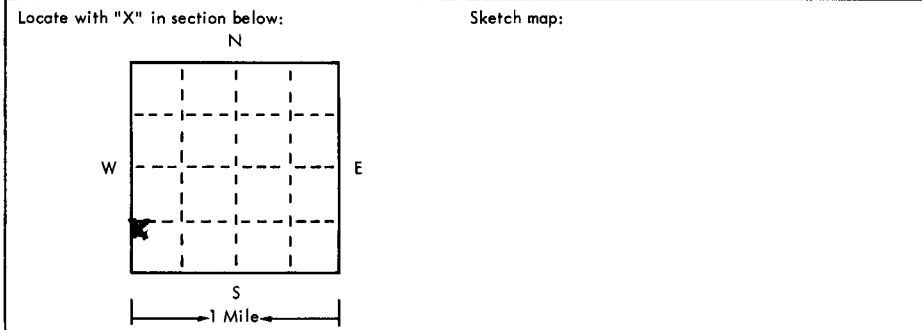

4 Well depth: 54 ft. Date of completion 6-1-75
 Well diameter 2 1/2 in.
 5 Cable tool Rotary Driven Dug
 Hollow rod Jetted Bored Reverse rotary
 6 Use: Domestic Public supply Industry
 Irrigation Air conditioning Commercial
 Test well
 7 Casing: Material _____ Height: above/below
 Threaded Welded Surface 12 in.
 Diam. _____ Weight 39 lbs./ft.
16 in. to 612 ft. depth Drive shoe? Yes No
 _____ in. to _____ ft. depth

2	Type and color of material	From	To
	<u>8/29 Brown</u>	<u>0</u>	<u>16</u>
	<u>Med Gravel & sand</u>	<u>16</u>	<u>30</u>
	<u>blue mud</u>	<u>30</u>	<u>33</u>
	<u>Gravel - med to coarse</u>	<u>33</u>	<u>53</u>
	<u>blue shale</u>	<u>53</u>	<u>54</u>

8 Screen:
 Manufacturer Johnson Casing Co
 Type 3/10T Dia. 16"
 Slot/gauze 3/8 Length 13'
 Set between 45 ft. and 54 ft.
 Fittings: _____
 Gravel pack Yes No Size range of material 4 to 5/8

9 Static water level:
16 ft. below land surface Date 6-4-75

10 Pumping level below land surfaces:
612 ft. after 7 hrs. pumping 500 g.p.m.
612 ft. after 6 hrs. pumping 500 g.p.m.
 Estimated maximum yield 500 g.p.m.

11 Water sample submitted:
 Yes No Date _____

12 Well head completion:
 Pitless adapter Inches above grade

13 Well grouted? Yes No
 Neat cement Bentonite _____
 Depth: From _____ ft. to _____ ft.

14 Nearest source of possible contamination:
 _____ ft. _____ Direction _____ Type _____
 Well disinfected upon completion? Yes No

15 Pump: Not installed
 Manufacturer's name Goards Inc
 Model number _____ HP 15 Volts 240
 Length of drop pipe 40 ft. capacity 500 g.p.m.
 Type:
 Submersible Turbine
 Jet Reciprocating
 Centrifugal Other

16 Remarks: elevation
 Topography:
 Hill
 Slope
 Upland
 Valley

17 Water well contractor's certification:
 This well was drilled under my jurisdiction and this report is true to the best of my knowledge and belief.
Pet Drilling Co 303
 Business name _____ License No. _____
 Address Bill City, Kan
 Signed Allen J. Jones Date 7-25-75
 Authorized representative

4 15W 35 NWSWSW