

MW #3


1 LOCATION OF WATER WELL: Fraction NW 1/4 NE 1/4 SW 1/4 Section Number 27 Township Number T 4 S Range Number R 16 E 10  
 County: Phillips

Distance and direction from nearest town or city street address of well if located within city?

Kirwin, KS

2 WATER WELL OWNER: Kensington Coop  
 RR#, St. Address, Box #: Box 128  
 City, State, ZIP Code: Kensington, KS 66951  
 Board of Agriculture, Division of Water Resources  
 Application Number:

3 LOCATE WELL'S LOCATION WITH AN "X" IN SECTION BOX:

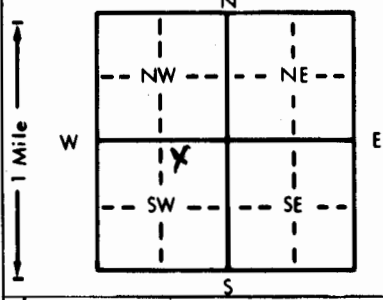

4 DEPTH OF COMPLETED WELL: 50.0 ft. ELEVATION:  
 Depth(s) Groundwater Encountered 1. 35.6 ft. 2. ft. 3. ft.  
 WELL'S STATIC WATER LEVEL: 36.01 ft. below land surface measured on mo/day/yr 4/10/89  
 Pump test data: Well water was ft. after hours pumping gpm  
 Est. Yield gpm: Well water was ft. after hours pumping gpm  
 Bore Hole Diameter: 12.0 in. to 50.0 ft., and in. to ft.  
 WELL WATER TO BE USED AS:  
 5 Public water supply 8 Air conditioning 11 Injection well  
 1 Domestic 3 Feedlot 6 Oil field water supply 9 Dewatering 12 Other (Specify below)  
 2 Irrigation 4 Industrial 7 Lawn and garden only 10 Monitoring well  
 Was a chemical/bacteriological sample submitted to Department? Yes.....No.....X; If yes, mo/day/yr sample was submitted  
 Water Well Disinfected? Yes No X

5 TYPE OF BLANK CASING USED:  
 1 Steel 3 RMP (SR) 5 Wrought iron 8 Concrete tile CASING JOINTS: Glued.....Clamped.....  
 2 PVC 4 ABS 6 Asbestos-Cement 9 Other (specify below) Welded.....X  
 7 Fiberglass Threaded.....X  
 Blank casing diameter: 4.0 in. to 30.0 ft., Dia. in. to ft., Dia. in. to ft.  
 Casing height above land surface: 0 in., weight 2 lbs./ft. Wall thickness or gauge No. 40

TYPE OF SCREEN OR PERFORATION MATERIAL:  
 1 Steel 3 Stainless steel 5 Fiberglass 7 PVC 10 Asbestos-cement  
 2 Brass 4 Galvanized steel 6 Concrete tile 8 RMP (SR) 11 Other (specify).....  
 12 None used (open hole)  
 SCREEN OR PERFORATION OPENINGS ARE:  
 1 Continuous slot 3 Mill slot 5 Gauzed wrapped 8 Saw cut 11 None (open hole)  
 2 Louvered shutter 4 Key punched 6 Wire wrapped 9 Drilled holes  
 7 Torch cut 10 Other (specify).....  
 SCREEN-PERFORATED INTERVALS: From 30.0 ft. to 50.0 ft., From ft. to ft.  
 From ft. to ft., From ft. to ft.  
 GRAVEL PACK INTERVALS: From 28.0 ft. to 50.0 ft., From ft. to ft.  
 From ft. to ft., From ft. to ft.

6 GROUT MATERIAL: 1 Neat cement 2 Cement grout 3 Bentonite 4 Other.....  
 Grout intervals: From 0 ft. to 28.0 ft., From ft. to ft., From ft. to ft.  
 What is the nearest source of possible contamination:  
 1 Septic tank 4 Lateral lines 7 Pit privy 10 Livestock pens 14 Abandoned water well  
 2 Sewer lines 5 Cess pool 8 Sewage lagoon 11 Fuel storage 15 Oil well/Gas well  
 3 Watertight sewer lines 6 Seepage pit 9 Feedyard 12 Fertilizer storage 16 Other (specify below)  
 13 Insecticide storage  
 Direction from well? North How many feet? 220

| FROM | TO | LITHOLOGIC LOG    | FROM | TO | PLUGGING INTERVALS |
|------|----|-------------------|------|----|--------------------|
| 0    | 30 | Clay/Silt<br>Silt |      |    |                    |
| 30   | 50 |                   |      |    |                    |
|      |    |                   |      |    |                    |
|      |    |                   |      |    |                    |
7 CONTRACTOR'S OR LANDOWNER'S CERTIFICATION: This water well was (1) constructed, (2) reconstructed, or (3) plugged under my jurisdiction and was completed on (mo/day/year) 2/24/89 and this record is true to the best of my knowledge and belief. Kansas Water Well Contractor's License No. 496 This Water Well Record was completed on (mo/day/yr) 3-9-89 under the business name of Groundwater Technology by (signature) [Signature]