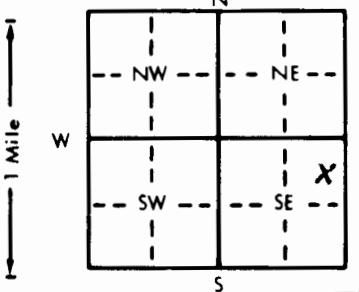


1 LOCATION OF WATER WELL: Fraction NE 1/4 NE 1/4 SE 1/4 Section Number 28 Township Number T 4 S Range Number R 16 E/W
 County: Phillips

Distance and direction from nearest town or city street address of well if located within city?
 SE corner 4th & Genoso Street, Kirwin Kansas 160' South of Genoso

2 WATER WELL OWNER: Kensington Co-Op Association
 RR#, St. Address, Box #: PO Box 128 Board of Agriculture, Division of Water Resources
 City, State, ZIP Code: Kensington, Kansas 66951 Application Number:

3 LOCATE WELL'S LOCATION WITH AN "X" IN SECTION BOX:  DEPTH OF COMPLETED WELL: 66.3 ft. ELEVATION: ... ft.
 Depth(s) Groundwater Encountered 1. ... 36.71 ... ft. 2. ... ft. 3. ... ft.
 WELL'S STATIC WATER LEVEL: 39.21 ft. below land surface measured on mo/day/yr 10-5-90/14:30
 Pump test data: Well water was ... ft. after ... hours pumping ... gpm
 Est. Yield ... gpm: Well water was ... ft. after ... hours pumping ... gpm
 Bore Hole Diameter: .8 in. to .67 ft., and ... in. to ... ft.
 WELL WATER TO BE USED AS: 5 Public water supply 8 Air conditioning 11 Injection well
 1 Domestic 3 Feedlot 6 Oil field water supply 9 Dewatering 12 Other (Specify below)
 2 Irrigation 4 Industrial 7 Lawn and garden only 10 Monitoring well
 Was a chemical/bacteriological sample submitted to Department? Yes ... No ; If yes, mo/day/yr sample was submitted
 Water Well Disinfected? Yes No

5 TYPE OF BLANK CASING USED: 5 Wrought iron 8 Concrete tile CASING JOINTS: Glued ... Clamped ...
 1 Steel 3 RMP (SR) 6 Asbestos-Cement 9 Other (specify below) Welded ...
 2 PVC 4 ABS 7 Fiberglass Threaded
 Blank casing diameter: 2 in. to 56.06 ft., Dia. in. to ... ft., Dia. in. to ... ft.
 Casing height above land surface: 2.60 in., weight: 0.70 lbs./ft. Wall thickness or gauge No. 0.308 in.
 TYPE OF SCREEN OR PERFORATION MATERIAL: 7 PVC 10 Asbestos-cement
 1 Steel 3 Stainless steel 5 Fiberglass 8 RMP (SR) 11 Other (specify) ...
 2 Brass 4 Galvanized steel 6 Concrete tile 9 ABS 12 None used (open hole)
 SCREEN OR PERFORATION OPENINGS ARE: 5 Gauzed wrapped 8 Saw cut 11 None (open hole)
 1 Continuous slot 3 Mill slot 6 Wire wrapped 9 Drilled holes
 2 Louvered shutter 4 Key punched 7 Torch cut 10 Other (specify) ...
 SCREEN-PERFORATED INTERVALS: From 56.06 ft. to 66.3 ft., From ... ft. to ... ft.
 GRAVEL PACK INTERVALS: From 52 ft. to 66.3 ft., From ... ft. to ... ft.

6 GROUT MATERIAL: 1 Neat cement 2 Cement grout 3 Bentonite 4 Other ...
 Grout Intervals: From 48 ft. to 1.0 ft., From ... ft. to ... ft., From ... ft. to ... ft.
 What is the nearest source of possible contamination:
 1 Septic tank 4 Lateral lines 7 Pit privy 10 Livestock pens 14 Abandoned water well
 2 Sewer lines 5 Cess pool 8 Sewage lagoon 11 Fuel storage 15 Oil well/Gas well
 3 Watertight sewer lines 6 Seepage pit 9 Feedyard 12 Fertilizer storage 16 Other (specify below)
 13 Insecticide storage
 Direction from well? Northwest How many feet? 250'

FROM	TO	LITHOLOGIC LOG	FROM	TO	PLUGGING INTERVALS
0	2	Silty clay, dark brown, moist, rather stiff (Top soil)			
2	20	Silty clay, dark brown, moist, rather stiff, roots, calcareous veins (ML-CL)			
20	25	Silt, brown, moist, rather stiff, sand lens 1" thick, Magnesium Nodules (ML)			
25	35	Silty clay, brown, moist, medium stiff silty sand lens 1" thick (CL-ML)			
35	39	Clay with silt, dark brown, saturated, soft (CL)			
39	49	Silty clay, dark brown, saturated soft (CL-ML)			
49	50.5	Clay, black, saturated, rather stiff, (CL)			
50.5	52	Clay, Blue-Gray, moist, rather stiff (CL)			
52	66	Sand, fine to medium grained, tan, saturated (SP)			
66	67	Clay, black, moist, rather stiff (CL)			

7 CONTRACTOR'S OR LANDOWNER'S CERTIFICATION: This water well was (1) constructed, (2) reconstructed, or (3) plugged under my jurisdiction and was completed on (mo/day/year) 10-5-90 and this record is true to the best of my knowledge and belief. Kansas Water Well Contractor's License No. 495 This Water Well Record was completed on (mo/day/yr) 10-30-90 under the business name of Nebraska Testing Corporation by (signature) *Neil A. W...*