


1 LOCATION OF WATER WELL: County: Phillips Fraction: NE 1/4 NE 1/4 NE 1/4 Section Number: 35 Township Number: T 4 S Range Number: R 16 EW

Distance and direction from nearest town or city street address of well if located within city?
2 mile EAST Kirwin

2 WATER WELL OWNER: Hawk Kuikun
RR#, St. Address, Box #: Kirwin KANSAS
City, State, ZIP Code: _____
Board of Agriculture, Division of Water Resources
Application Number: _____

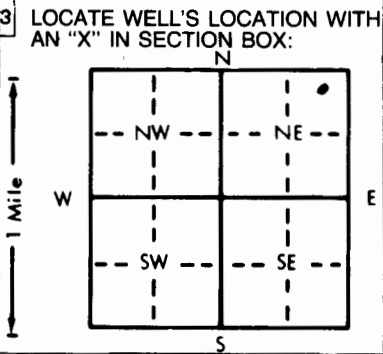

4 DEPTH OF COMPLETED WELL: 90' ft. ELEVATION: _____
Depth(s) Groundwater Encountered 1. 45' ft. 2. 90' ft. 3. _____ ft.
WELL'S STATIC WATER LEVEL: 45' ft. below land surface measured on mo/day/yr 6-10-88
Pump test data: Well water was 45 ft. after 2 hours pumping 15 gpm
Est. Yield 40 gpm: Well water was 45 ft. after 3 hours pumping 15 gpm
Bore Hole Diameter: 11 in. to 90 ft., and _____ in. to _____ ft.
WELL WATER TO BE USED AS:
5 Public water supply 8 Air conditioning 11 Injection well
1 Domestic 3 Feedlot 6 Oil field water supply 9 Dewatering 12 Other (Specify below)
2 Irrigation 4 Industrial 7 Lawn and garden only 10 Observation well
Was a chemical/bacteriological sample submitted to Department? Yes _____ No X; If yes, mo/day/yr sample was sub-
mitted _____ Water Well Disinfected? Yes X No _____

5 TYPE OF BLANK CASING USED:
1 Steel 3 RMP (SR) 5 Wrought iron 8 Concrete tile CASING JOINTS: Glued X Clamped _____
2 PVC 4 ABS 6 Asbestos-Cement 9 Other (specify below) Welded _____
7 Fiberglass Threaded _____
Blank casing diameter 5" in. to 90' ft., Dia _____ in. to _____ ft., Dia _____ in. to _____ ft.
Casing height above land surface 3' in., weight 160# lbs./ft. Wall thickness or gauge No. _____

TYPE OF SCREEN OR PERFORATION MATERIAL:
1 Steel 3 Stainless steel 5 Fiberglass 7 PVC 10 Asbestos-cement
2 Brass 4 Galvanized steel 6 Concrete tile 8 RMP (SR) 11 Other (specify) _____
9 ABS 12 None used (open hole)

SCREEN OR PERFORATION OPENINGS ARE:
1 Continuous slot 3 Mill slot 5 Gauzed wrapped 8 Saw cut 11 None (open hole)
2 Louvered shutter 4 Key punched 6 Wire wrapped 9 Drilled holes
7 Torch cut 10 Other (specify) _____

SCREEN-PERFORATED INTERVALS: From 70' ft. to 90' ft., From _____ ft. to _____ ft.
From _____ ft. to _____ ft., From _____ ft. to _____ ft.
GRAVEL PACK INTERVALS: From 70' ft. to 90' ft., From _____ ft. to _____ ft.
From _____ ft. to _____ ft., From _____ ft. to _____ ft.

6 GROUT MATERIAL: 1 Neat cement 2 Cement grout 3 Bentonite 4 Other _____
Grout Intervals: From 0 ft. to 20' ft., From _____ ft. to _____ ft., From _____ ft. to _____ ft.
What is the nearest source of possible contamination:
1 Septic tank 4 Lateral lines 7 Pit privy 10 Livestock pens 14 Abandoned water well
2 Sewer lines 5 Cess pool 8 Sewage lagoon 11 Fuel storage 15 Oil well/Gas well
3 Watertight sewer lines 6 Seepage pit 9 Feedyard 12 Fertilizer storage 16 Other (specify below)
13 Insecticide storage _____
Direction from well? _____ How many feet? _____

FROM	TO	LITHOLOGIC LOG	FROM	TO	LITHOLOGIC LOG
<u>0</u>	<u>5</u>	<u>Bl soil</u>			
<u>5</u>	<u>40</u>	<u>CLAY</u>			
<u>40</u>	<u>45</u>	<u>Rock & SAND</u>			
<u>45</u>	<u>90</u>	<u>GRAVEL</u>			
	<u>90</u>	<u>SHALE</u>			

7 CONTRACTOR'S OR LANDOWNER'S CERTIFICATION: This water well was (1) constructed, (2) reconstructed, or (3) plugged under my jurisdiction and was completed on (mo/day/year) 6-8-88 and this record is true to the best of my knowledge and belief. Kansas Water Well Contractor's License No. 229 This Water Well Record was completed on (mo/day/yr) 6-10-88 under the business name of Redinger Drilling by (signature) Warren Redinger

INSTRUCTIONS: Use typewriter or ball point pen, PLEASE PRESS FIRMLY and PRINT clearly. Please fill in blanks, underline or circle the correct answers. Send top three copies to Kansas Department of Health and Environment, Division of Environment, Environmental Geology Section, Topeka, KS 66620. Send one to WATER WELL OWNER and retain one for your records.

OFFICE USE ONLY

T

1

R

1

6

EM

35

SEC.

35

1/4

1/4

1/4