


WATER WELL RECORD Form WWC-5 KSA 82a-1212

1 LOCATION OF WATER WELL: PHILLIPSA County: SE 1/4 SE 1/4 SE 1/4 Section Number 7 Township Number T 4 S Range Number R 17 E/W

Distance and direction from nearest town or city street address of well if located within city?  
2 MILES EAST @ 2 1/2 MILES NORTH OF GLADE KS

2 WATER WELL OWNER: ROBERT JOHNSON  
RR#, St. Address, Box #: RT 3 Board of Agriculture, Division of Water Resources  
City, State, ZIP Code: PHILLIPSBURG KS 67661 Application Number:

3 LOCATE WELL'S LOCATION WITH AN "X" IN SECTION BOX:

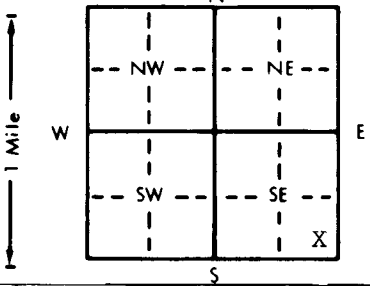

4 DEPTH OF COMPLETED WELL: 60 ft. ELEVATION:  
Depth(s) Groundwater Encountered 1. 45 ft. 2. ft. 3. ft.  
WELL'S STATIC WATER LEVEL 45 ft. below land surface measured on mo/day/yr 9-18-97  
Pump test data: Well water was ft. after hours pumping gpm  
Est. Yield 80-100 gpm: Well water was ft. after hours pumping gpm  
Bore Hole Diameter 10 in. to 60 ft., and in. to ft.  
WELL WATER TO BE USED AS: 5 Public water supply 8 Air conditioning 11 Injection well  
XX Domestic 3 Feedlot 6 Oil field water supply 9 Dewatering 12 Other (Specify below)  
2 Irrigation 4 Industrial 7 Lawn and garden only 10 Monitoring well  
Was a chemical/bacteriological sample submitted to Department? Yes No XX; If yes, mo/day/yr sample was submitted Water Well Disinfected? Yes No XX

5 TYPE OF BLANK CASING USED: 5 Wrought iron 8 Concrete tile CASING JOINTS: Glued XX Clamped  
1 Steel 3 RMP (SR) 6 Asbestos-Cement 9 Other (specify below) Welded  
XX PVC 4 ABS 7 Fiberglass Threaded  
Blank casing diameter 5 in. to 40 ft., Dia in. to ft., Dia in. to ft.  
Casing height above land surface 18 in., weight 160 lbs./ft. Wall thickness or gauge No.  
TYPE OF SCREEN OR PERFORATION MATERIAL: XX PVC 10 Asbestos-cement  
1 Steel 3 Stainless steel 5 Fiberglass 8 RMP (SR) 11 Other (specify)  
2 Brass 4 Galvanized steel 6 Concrete tile 9 ABS 12 None used (open hole)  
SCREEN OR PERFORATION OPENINGS ARE: 5 Gauzed wrapped 8 Saw cut 11 None (open hole)  
1 Continuous slot 3 Mill slot 6 Wire wrapped 9 Drilled holes  
2 Louvered shutter 4 Key punched 7 Torch cut 10 Other (specify)  
SCREEN-PERFORATED INTERVALS: From 40 ft. to 60 ft., From ft. to ft.  
GRAVEL PACK INTERVALS: From 25 ft. to 60 ft., From ft. to ft.

6 GROUT MATERIAL: 1 Neat cement 2 Cement grout XX Bentonite 4 Other  
Grout Intervals: From 0 ft. to 25 ft., From ft. to ft., From ft. to ft.  
What is the nearest source of possible contamination:  
1 Septic tank 4 Lateral lines 7 Pit privy 10 Livestock pens 14 Abandoned water well  
2 Sewer lines 5 Cess pool 8 Sewage lagoon 11 Fuel storage 15 Oil well/Gas well  
3 Watertight sewer lines 6 Seepage pit 9 Feedyard 12 Fertilizer storage 16 Other (specify below)  
13 Insecticide storage  
Direction from well? How many feet?

FROM	TO	LITHOLOGIC LOG	FROM	TO	PLUGGING INTERVALS
0	12	SURFACE CLAY			
12	25	HARD GRAY CLAY			
25	40	BLUE MUD			
40	45	FINE SAND			
45	57	LARGE SAND			
57	60	BLUE SHALE			

7 CONTRACTOR'S OR LANDOWNER'S CERTIFICATION: This water well was (1) constructed, (2) reconstructed, or (3) plugged under my jurisdiction and was completed on (mo/day/year) 9-18-97 and this record is true to the best of my knowledge and belief. Kansas Water Well Contractor's License No. 444 This Water Well Record was completed on (mo/day/yr) 9-18-97 under the business name of ANDY ANDERSON DRILLING by (signature) Andy Anderson

INSTRUCTIONS: Use typewriter or ball point pen. PLEASE PRESS FIRMLY and PRINT clearly. Please fill in blanks, underline or circle the correct answers. Send top three copies to Kansas Department of Health and Environment, Bureau of Water, Topeka, Kansas 66620-0001. Telephone: 913-296-5545. Send one to WATER WELL OWNER and retain one for your records.

OFFICE USE ONLY T R E/W SEC. 1/4 1/4 1/4