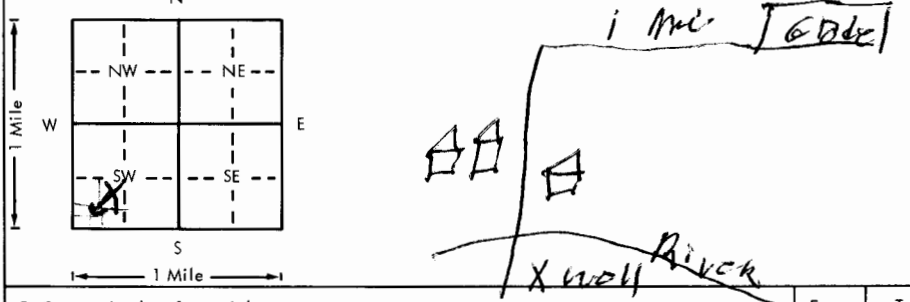


USE TYPEWRITER OR BALL
POINT PEN-PRESS FIRMLY,
PRINT CLEARLY.

WATER WELL RECORD
KSA 82a-1201-1215

Kansas Department of Health and
Environment-Division of Environment
(Water well Contractors)
Topeka, Kansas 66620

1. Location of well:		County Phillips	Fraction SW 1/4 SW 1/4 SW 1/4	Section number 26	Township number T 4 S	Range number R 18 E/W
2. Distance and direction from nearest town or city: 1 1/2 miles Street address of well location if in city: Glade, Kansas				3. Owner of well: CITY OF Phillipsburg R.R. or street: City, state, zip code: Phillipsburg, Kan 66661		
4. Locate with "X" in section below:		Sketch map:		6. Bore hole dia. 30 in. Completion date 3-31-78 Well depth 52 ft.		
				7. Cable tool <input type="checkbox"/> Rotary <input type="checkbox"/> Driven <input type="checkbox"/> Dug <input type="checkbox"/> Hollow rod <input type="checkbox"/> Jetted <input type="checkbox"/> Bored <input checked="" type="checkbox"/> Reverse rotary		
5. Type and color of material		From To		8. Use: Domestic <input checked="" type="checkbox"/> Public supply <input type="checkbox"/> Industry <input type="checkbox"/> Irrigation <input type="checkbox"/> Air conditioning <input type="checkbox"/> Stock <input type="checkbox"/> Lawn <input type="checkbox"/> Oil field water <input type="checkbox"/> Other <input type="checkbox"/>		
Top soil		0 7		9. Casing: Material transite Height: Above or below <input checked="" type="checkbox"/> Threaded <input type="checkbox"/> Welded <input type="checkbox"/> Surface 22 in. RMP <input type="checkbox"/> PVC <input type="checkbox"/> Weight 34 lbs./ft. Dia. 16 in. to 52 ft. depth Wall Thickness: inches or Dia. <input type="checkbox"/> in. to <input type="checkbox"/> ft. depth gage No. 17.5		
Sand (Fine Brown)		7 21		10. Screen: Manufacturer's name Johnson Casing Co. Type transite Dia. 16 Slot/gauze 3/16 Length 24 1/2 Set between 34 ft. and 35 1/2 ft. Gravel pack? <input checked="" type="checkbox"/> Size range of material 4/70 5/6		
Blue mud		21 35		11. Static water level: <input type="checkbox"/> mo./day/yr. 16 ft. below land surface Date 3-31-78		
Gravel		35 50		12. Pumping level below land surfaces: 50 ft. after 8 hrs. pumping 200 g.p.m. ft. after <input type="checkbox"/> hrs. pumping <input type="checkbox"/> g.p.m. Estimated maximum yield 200 g.p.m.		
Shale		50 52		13. Water sample submitted: <input type="checkbox"/> mo./day/yr. <input checked="" type="checkbox"/> Yes <input type="checkbox"/> No Date 78		
				14. Well head completion: NOT done Pitless adapter <input type="checkbox"/> Inches above grade		
				15. Well grouted? yes With: Neat cement <input type="checkbox"/> Bentonite <input checked="" type="checkbox"/> Concrete <input type="checkbox"/> Depth: From 0 ft. to 26 ft.		
				16. Nearest source of possible contamination: From ft. 1500 Direction NW Type 5702d Well disinfected upon completion? <input checked="" type="checkbox"/> Yes <input type="checkbox"/> No		
				17. Pump: <input checked="" type="checkbox"/> Not installed Manufacturer's name <input type="checkbox"/> Model number <input type="checkbox"/> HP <input type="checkbox"/> Volts <input type="checkbox"/> Length of drop pipe <input type="checkbox"/> ft. capacity <input type="checkbox"/> g.p.m. Type: <input type="checkbox"/> Submersible <input type="checkbox"/> Turbine <input type="checkbox"/> Jet <input type="checkbox"/> Reciprocating <input type="checkbox"/> Centrifugal <input type="checkbox"/> Other		
18. Elevation:		19. Remarks:		20. Water well contractor's certification:		
Topography: <input type="checkbox"/> Hill <input type="checkbox"/> Slope <input type="checkbox"/> Upland <input checked="" type="checkbox"/> Valley		To be set up 6' & cemented		This well was drilled under my jurisdiction and this report is true to the best of my knowledge and belief. DLK Drilling 303 Business name Box 363 License No. 446764 Address Hill City, Kan Signed Allen J. Davis Date 3-31-78 Authorized representative		