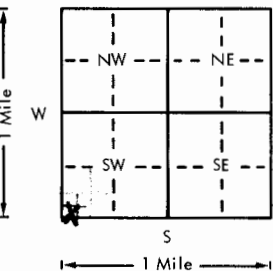
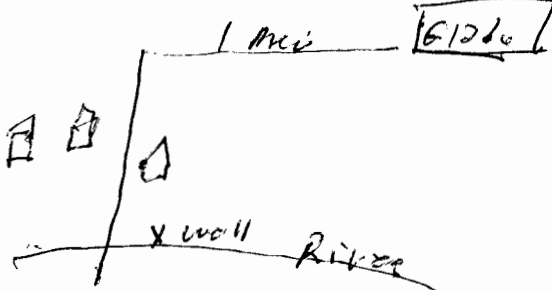


USE TYPEWRITER OR BALL
POINT PEN-PRESS FIRMLY,
PRINT CLEARLY.

WATER WELL RECORD
KSA 82a-1201-1215

Kansas Department of Health and
Environment-Division of Environment
(Water well Contractors)
Topeka, Kansas 66620

1. Location of well:		County Phillips	Fraction SW 1/4 SW 1/4 SW 1/4	Section number 26	Township number T 4	Range number S R 18	E/W																		
2. Distance and direction from nearest town or city: 1 mi south of Glade, Kan				3. Owner of well: CITY OF PHILLIPS BENG R.R. or street: City, state, zip code: Phillips beng, Kan 67661																					
4. Locate with "X" in section below:		Sketch map:		6. Bore hole dia. 30 in. Completion date 3-30-78 Well depth 52 ft.																					
				7. <input type="checkbox"/> Cable tool <input type="checkbox"/> Rotary <input type="checkbox"/> Driven <input type="checkbox"/> Dug <input type="checkbox"/> Hollow rod <input type="checkbox"/> Jetted <input type="checkbox"/> Bored <input checked="" type="checkbox"/> Reverse rotary																					
5. Type and color of material				8. Use: <input type="checkbox"/> Domestic <input checked="" type="checkbox"/> Public supply <input type="checkbox"/> Industry <input type="checkbox"/> Irrigation <input type="checkbox"/> Air conditioning <input type="checkbox"/> Stock <input type="checkbox"/> Lawn <input type="checkbox"/> Oil field water <input type="checkbox"/> Other																					
<table border="1"><thead><tr><th></th><th>From</th><th>To</th></tr></thead><tbody><tr><td>Top soil</td><td>0</td><td>5</td></tr><tr><td>Sand (Fine Brown)</td><td>5</td><td>21</td></tr><tr><td>Blue mud</td><td>21</td><td>33</td></tr><tr><td>Gravel (Med.)</td><td>33</td><td>51</td></tr><tr><td>Shale</td><td>51</td><td>52</td></tr></tbody></table>					From	To	Top soil	0	5	Sand (Fine Brown)	5	21	Blue mud	21	33	Gravel (Med.)	33	51	Shale	51	52	9. Casing: Material Transite Height Above or below Threaded <input type="checkbox"/> Welded <input type="checkbox"/> Surface <input type="checkbox"/> in. RMP <input type="checkbox"/> PVC <input type="checkbox"/> Weight 34 lbs./ft. Dia. 16 in. to 52 ft. depth Wall Thickness: inches or Dia. <input type="checkbox"/> in. to <input type="checkbox"/> ft. depth gage No. 27514			
					From	To																			
Top soil	0	5																							
Sand (Fine Brown)	5	21																							
Blue mud	21	33																							
Gravel (Med.)	33	51																							
Shale	51	52																							
10. Screen: Manufacturer's name Johnson Casing Co. Dia. 16 Type Transite Slot/auze 3/16 Length 36 Set between 21 ft. and 52 ft. Gravel pack? yes Size range of material 1/2 to 3/4																									
11. Static water level: 9.5 ft. below land surface Date 3-28-78				12. Pumping level below land surfaces: 50 ft. after 8 hrs. pumping 300 g.p.m. ft. after <input type="checkbox"/> hrs. pumping <input type="checkbox"/> g.p.m. Estimated maximum yield 300 g.p.m.																					
13. Water sample submitted: <input checked="" type="checkbox"/> Yes <input type="checkbox"/> No Date 78				14. Well head completion: NOT done <input type="checkbox"/> Pitless adapter <input type="checkbox"/> inches above grade																					
15. Well grouted? yes With: <input type="checkbox"/> Neat cement <input type="checkbox"/> Bentonite <input checked="" type="checkbox"/> Concrete Depth: From 20 ft. to 26 ft.				16. Nearest source of possible contamination: Farm ft. 100 Direction 46 Type stead Well disinfected upon completion? <input checked="" type="checkbox"/> Yes <input type="checkbox"/> No																					
17. Pump: <input checked="" type="checkbox"/> Not installed Manufacturer's name <input type="checkbox"/> HP <input type="checkbox"/> Volts <input type="checkbox"/> Length of drop pipe <input type="checkbox"/> ft. capacity <input type="checkbox"/> g.p.m. Type: <input type="checkbox"/> Submersible <input type="checkbox"/> Turbine <input type="checkbox"/> Jet <input type="checkbox"/> Reciprocating <input type="checkbox"/> Centrifugal <input type="checkbox"/> Other				20. Water well contractor's certification: This well was drilled under my jurisdiction and this report is true to the best of my knowledge and belief. DLL Drilling Co 303 Business name Box 368 License No. 67642 Address Hill City Mo 67642 Signed attest to Date 3-30-78 Authorized representative																					
18. Elevation:		19. Remarks:		20. Water well contractor's certification:																					
Topography: <input type="checkbox"/> Hill <input type="checkbox"/> Slope <input type="checkbox"/> Upland <input checked="" type="checkbox"/> Valley		To be set 6' Above Ground Level & cemented with 36" Road culbert																							