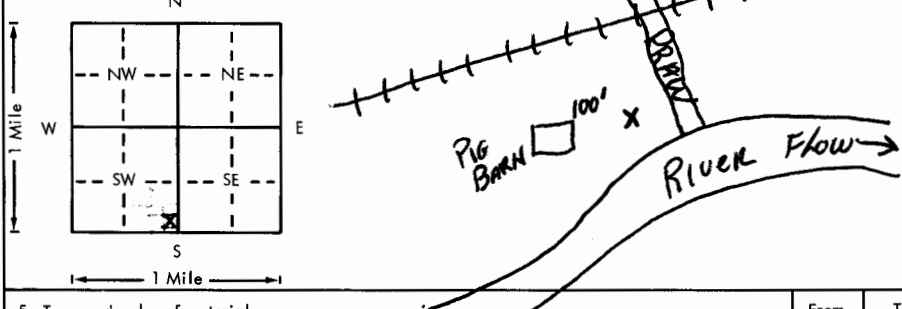


USE TYPEWRITER OR BALL
POINT PEN-PRESS FIRMLY,
PRINT CLEARLY.

WATER WELL RECORD
KSA 82a-1201-1215

SPEED

Kansas Department of Health and
Environment-Division of Environment
(Water well Contractors)
Topeka, Kansas 66620

1. Location of well:		County Phillips	Fraction SE 1/4 SE 1/4 SW 1/4	Section number 29	Township number T 4 S	Range number R 18 W
2. Distance and direction from nearest town or city: 2 miles East 1 South & 1/2 East of Speed Street address of well location if in city:				3. Owner of well: John Van Der Wege R.R. or street: Glade, Kansas City, state, zip code: 67639		
4. Locate with "X" in section below:		Sketch map:		6. Bore hole dia. 9 1/2 in. Completion date 6/13/78 Well depth 42 ft.		
				7. <input checked="" type="checkbox"/> Cable tool <input type="checkbox"/> Rotary <input type="checkbox"/> Driven <input type="checkbox"/> Dug <input type="checkbox"/> Hollow rod <input type="checkbox"/> Jetted <input type="checkbox"/> Bored <input type="checkbox"/> Reverse rotary		
5. Type and color of material		From	To	8. Use: <input type="checkbox"/> Domestic <input type="checkbox"/> Public supply <input type="checkbox"/> Industry <input type="checkbox"/> Irrigation <input type="checkbox"/> Air conditioning <input checked="" type="checkbox"/> Stock <input type="checkbox"/> Lawn <input type="checkbox"/> Oil field water <input type="checkbox"/> Other		
Top Soil		0	4	9. Casing: Material <input type="checkbox"/> Height: Above or below Threaded <input type="checkbox"/> Welded <input type="checkbox"/> Surface 18 in. RMP <input type="checkbox"/> PVC <input checked="" type="checkbox"/> Weight <input type="checkbox"/> lbs./ft. Dia. 6 in. to 42 ft. depth Wall Thickness: inches or Dia. <input type="checkbox"/> in. to <input type="checkbox"/> ft. depth gage No. 200#		
Lt. Yellow Clay		4	20	10. Screen: Manufacturer's name Western		
Fine Sand & Yellow Clay		20	30	Type <input type="checkbox"/> Dia. 6" Slot/gauze 1/8" Length 8' Set between 34 ft. and 42 ft. <input type="checkbox"/> ft. and <input type="checkbox"/> ft.		
Med. Sand & Gravel		30	39	Gravel pack? Yes Size range of material 1/2" minus		
Coarse Gravel & Chalk Rock		39	42	11. Static water level: <input type="checkbox"/> mo./day/yr. 22 ft. below land surface Date 6/13/78		
Shale		42		12. Pumping level below land surfaces: <input type="checkbox"/> ft. after <input type="checkbox"/> hrs. pumping <input type="checkbox"/> g.p.m. <input type="checkbox"/> ft. after <input type="checkbox"/> hrs. pumping <input type="checkbox"/> g.p.m. Estimated maximum yield 40 g.p.m.		
42'				13. Water sample submitted: <input type="checkbox"/> mo./day/yr. <input type="checkbox"/> Yes <input checked="" type="checkbox"/> No Date		
22'				14. Well head completion: <input type="checkbox"/> Pitless adapter 18 inches above grade		
20's. + 1/2 in.				15. Well grouted? Yes With: <input type="checkbox"/> Neat cement <input checked="" type="checkbox"/> Bentonite <input type="checkbox"/> Concrete Depth: From 0 ft. to 13 ft.		
NOT in				16. Nearest source of possible contamination: ft. 100 Direction West Type Pig Barn Well disinfected upon completion? <input type="checkbox"/> Yes <input checked="" type="checkbox"/> No		
1815				17. Pump: <input checked="" type="checkbox"/> Not installed Manufacturer's name <input type="checkbox"/> Model number <input type="checkbox"/> HP <input type="checkbox"/> Volts <input type="checkbox"/> Length of drop pipe <input type="checkbox"/> ft. capacity <input type="checkbox"/> g.p.m. Type: <input type="checkbox"/> Submersible <input type="checkbox"/> Turbine <input type="checkbox"/> Jet <input type="checkbox"/> Reciprocating <input type="checkbox"/> Centrifugal <input type="checkbox"/> Other		
(Use a second sheet if needed)				20. Water well contractor's certification: This well was drilled under my jurisdiction and this report is true to the best of my knowledge and belief. Deer Drilling 3/14 Business name License No. Address Phillipsburg, Kansas Signed William J. Deer Date 6-13-78 Authorized representative		
18. Elevation:		19. Remarks:				
Topography: <input checked="" type="checkbox"/> Hill <input type="checkbox"/> Slope <input type="checkbox"/> Upland <input type="checkbox"/> Valley						