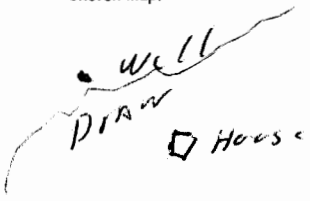


USE TYPEWRITER OR BALL
POINT PEN-PRESS FIRMLY,
PRINT CLEARLY.

WATER WELL RECORD
KSA 82a-1201-1215

Kansas Department of Health and
Environment-Division of Environment
(Water well Contractors)
Topeka, Kansas 66620

1. Location of well:		County Phillips	Fraction CS 1/2 NWNW	Section number 14	Township number T 4	Range number S 19 W E/W
2. Distance and direction from nearest town or city: Street address of well location if in city:		3 miles North 1 mile West of Speed, KS		3. Owner of well: R. A. Morgan R.R. or street: GLADE KANS 67639 City, state, zip code:		
4. Locate with "X" in section below: N W E S 1 Mile		Sketch map: 		6. Bore hole dia. 9 in. Completion date 5-5-74 Well depth 26 ft.		
5. Type and color of material		From	To	7. <input checked="" type="checkbox"/> Cable tool <input checked="" type="checkbox"/> Rotary <input type="checkbox"/> Driven <input type="checkbox"/> Dug <input type="checkbox"/> Hollow rod <input type="checkbox"/> Jetted <input type="checkbox"/> Bored <input type="checkbox"/> Reverse rotary		
BLACK DIRT		0	15	8. Use: <input checked="" type="checkbox"/> Domestic <input type="checkbox"/> Public supply <input type="checkbox"/> Industry <input type="checkbox"/> Irrigation <input type="checkbox"/> Air conditioning <input type="checkbox"/> Stock <input type="checkbox"/> Lawn <input type="checkbox"/> Oil field water <input type="checkbox"/> Other		
FINE SAND		15	20	9. Casing: Material PVC Height: Above or below Threaded <input type="checkbox"/> Welded <input checked="" type="checkbox"/> Surface 18 in. RMP <input type="checkbox"/> PVC <input checked="" type="checkbox"/> Weight 15 lbs./ft. Dia. 5 in. to 20 ft. depth Wall Thickness: inches or Dia. 5 in. to 20 ft. depth gage No. 200		
COARSE SAND		20	24	10. Screen: Manufacturer's name Pumpco Type PVC Dia. 5" Slot/gauze 1/8" Length 6' Set between 20 ft. and 26 ft. Gravel pack? <input checked="" type="checkbox"/> Size range of material 1/8 to 1/4		
Blue shale		24	26	11. Static water level: 15 ft. below land surface Date 5-5-74 mo./day/yr.		
Red 24' 24				12. Pumping level below land surfaces: 20 ft. after 1 hrs. pumping 20 g.p.m. ft. after 15 hrs. pumping 25 g.p.m. Estimated maximum yield 25 g.p.m.		
NOT in 28				13. Water sample submitted: Yes <input checked="" type="checkbox"/> No <input type="checkbox"/> Date 5-5-74 mo./day/yr.		
1945				14. Well head completion: Pitless adapter 18 inches above grade		
1921				15. Well grouted? Yes With: <input checked="" type="checkbox"/> Neat cement <input type="checkbox"/> Bentonite <input type="checkbox"/> Concrete Depth: From 12 ft. to 0 ft.		
1945				16. Nearest source of possible contamination: ft. 20 Direction EAST Type Circle Well disinfected upon completion? <input checked="" type="checkbox"/> Yes <input type="checkbox"/> No		
1945				17. Pump: <input checked="" type="checkbox"/> Not installed Manufacturer's name _____ Model number _____ HP _____ Volts _____ Length of drop pipe _____ ft. capacity _____ g.p.m. Type: <input type="checkbox"/> Submersible <input type="checkbox"/> Turbine <input type="checkbox"/> Jet <input type="checkbox"/> Reciprocating <input type="checkbox"/> Centrifugal <input type="checkbox"/> Other		
18. Elevation:		19. Remarks:		20. Water well contractor's certification: This well was drilled under my jurisdiction and this report is true to the best of my knowledge and belief. Paul Well Dig. 269A Business name _____ License No. _____ Address Palco, KS Signed Paul Well Dig. Date 5-5-74 Authorized representative		

Forward the white, blue and pink copies to the Department of Health and Environment

Form WWC-5