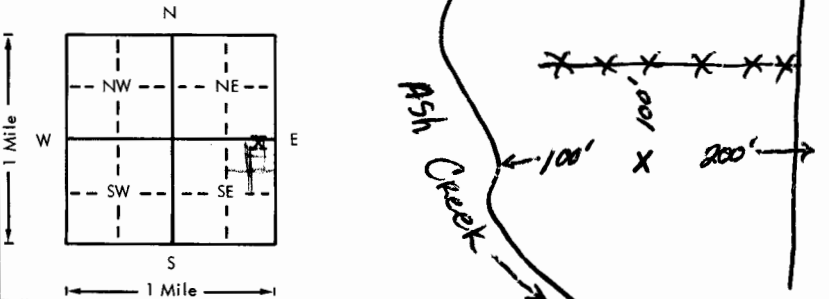


USE TYPEWRITER OR BALL  
POINT PEN-PRESS FIRMLY,  
PRINT CLEARLY.

WATER WELL RECORD  
KSA 82a-1201-1215

Kansas Department of Health and  
Environment-Division of Environment  
(Water well Contractors)  
Topeka, Kansas 66620

1. Location of well:		County <b>Phillips</b>	Fraction <b>NE 1/4 NE 1/4 SE 1/4</b>	Section number <b>23</b>	Township number <b>T 4 S</b>	Range number <b>R 19 W</b>
2. Distance and direction from nearest town or city: <b>1 mile north of Speed on west side of Rd.</b>				3. Owner of well: <b>Charles and Bill Duncan</b> R.R. or street: <b>RR 4</b> City, state, zip code: <b>Phillipsburg, Ks. 67661</b>		
4. Locate with "X" in section below:		Sketch map:		6. Bore hole dia. <b>9 3/4</b> in. Completion date <b>8-11-78</b> Well depth <b>31 1/2</b> ft.		
				7. <input checked="" type="checkbox"/> Cable tool <input type="checkbox"/> Rotary <input type="checkbox"/> Driven <input type="checkbox"/> Dug <input type="checkbox"/> Hollow rod <input type="checkbox"/> Jetted <input type="checkbox"/> Bored <input type="checkbox"/> Reverse rotary		
5. Type and color of material		From		To		8. Use: <input type="checkbox"/> Domestic <input type="checkbox"/> Public supply <input type="checkbox"/> Industry <input type="checkbox"/> Irrigation <input type="checkbox"/> Air conditioning <input checked="" type="checkbox"/> Stock <input type="checkbox"/> Lawn <input type="checkbox"/> Oil field water <input type="checkbox"/> Other
Top Soil		0		13		9. Casing: Material <input type="checkbox"/> Height: Above or <input checked="" type="checkbox"/> Below Threaded <input type="checkbox"/> Welded <input type="checkbox"/> Surface <b>2 1/2</b> in. RMP <input type="checkbox"/> PVC <input checked="" type="checkbox"/> Weight <input type="checkbox"/> lbs./ft. Dia. <b>6</b> in. to <b>3 1/2</b> ft. depth Wall Thickness: inches or Dia. <input type="checkbox"/> in. to <input type="checkbox"/> ft. depth gage No. <b>Sch. 200</b>
Lt. Brown Clay		13		27		10. Screen: Manufacturer's name <b>Western</b> Type <b>PVC</b> Dia. <b>6"</b> Slot/gauze <b>1/8"</b> Length <b>8'</b> Set between <b>3 1/2</b> ft. and <b>26</b> ft. ft. and <input type="checkbox"/> ft. Gravel pack? <b>yes</b> Size range of material <b>4" minus</b>
Fine Sand		27		30		11. Static water level: <input type="checkbox"/> mo./day/yr. <b>22</b> ft. below land surface Date <b>8-11-78</b>
Med. Gravel & Chalk Rock		30		32		12. Pumping level below land surfaces: ft. after <input type="checkbox"/> hrs. pumping <input type="checkbox"/> g.p.m. ft. after <input type="checkbox"/> hrs. pumping <input type="checkbox"/> g.p.m. Estimated maximum yield <b>12</b> g.p.m.
Shale		32		34		13. Water sample submitted: <input type="checkbox"/> mo./day/yr. Yes <input checked="" type="checkbox"/> No Date <input type="checkbox"/>
Noting						14. Well head completion: <input type="checkbox"/> Pitless adapter <b>2 1/2</b> inches above grade
1320						15. Well grouted? <b>yes</b> With: <input checked="" type="checkbox"/> Neat cement <input type="checkbox"/> Bentonite <input type="checkbox"/> Concrete Depth: From <b>5</b> ft. to <b>17</b> ft.
18.9						16. Nearest source of possible contamination: ft. <input type="checkbox"/> Direction <input type="checkbox"/> Type <b>NONE</b> Well disinfected upon completion? <input type="checkbox"/> Yes <input checked="" type="checkbox"/> No
						17. Pump: <input checked="" type="checkbox"/> Not installed Manufacturer's name <input type="checkbox"/> Model number <input type="checkbox"/> HP <input type="checkbox"/> Volts <input type="checkbox"/> Length of drop pipe <input type="checkbox"/> ft. capacity <input type="checkbox"/> g.p.m. Type: <input type="checkbox"/> Submersible <input type="checkbox"/> Turbine <input type="checkbox"/> Jet <input type="checkbox"/> Reciprocating <input type="checkbox"/> Centrifugal <input type="checkbox"/> Other
18. Elevation:		19. Remarks:		20. Water well contractor's certification: This well was drilled under my jurisdiction and this report is true to the best of my knowledge and belief. <b>Deer Drilling</b> <b>3/11</b> Business name <b>Rt 4 Phillipsburg, Ks.</b> License No. <input type="checkbox"/> Address <b>Phillipsburg, Ks.</b> Date <b>8-11-78</b> Signed <b>William J. Deer</b> Authorized representative		
Topography: <input checked="" type="checkbox"/> Hill <input type="checkbox"/> Slope <input type="checkbox"/> Upland <input type="checkbox"/> Valley		Customer may build a house near here and connect to this well				