USE TYPEWRITER OR BALL POINT PEN-PRESS FIRMLY, PRINT CLEARLY.

WATER WELL RECORD
KSA 82a-1201-1215

Kansas Department of Health and Environment-Division of Environment
(Water well Contractors)
Topeka, Kansas 66620

1. Location of well:	County	Fraction	Section number	Township number	Range number
	REPUBLIC	SE 1/4 NW 1/4 NE 1/4	19	T 4 S	R 2 E (W)

2. Distance and direction from nearest town or city: IN TALMO
Street address of well location if in city:

3. Owner of well: RURAL FIRE DIST #6
R.R. or street: TALMO, WAYNE
City, state, zip code: % STANLEY KROONE

4. Locate with "X" in section below:

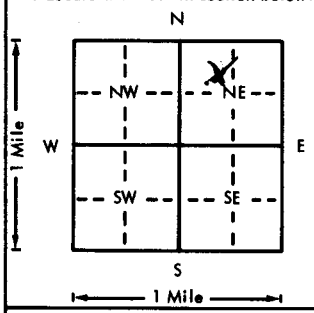

Sketch map: AGENDA, KANS 66930

118 D

6. Bore hole dia. 10 in. Completion date
Well depth 67 ft. 3/22/76

7. X Cable tool ___ Rotary ___ Driven ___ Dug
___ Hollow rod ___ Jetted ___ Bored ___ Reverse rotary

8. Use: X Domestic ___ Public supply ___ Industry
___ Irrigation ___ Air conditioning ___ Stock
___ Lawn ___ Oil field water ___ Other

9. Casing: Material PVC Height: Above or below
Threaded ___ Welded X Surface 18" in.
RMP ___ PVC X Weight 4 lbs./ft.
Dia. 6 in. to 67 ft. depth Wall Thickness: inches or
Dia. ___ in. to ___ ft. depth gage No.

5. Type and color of material	From	To
TOPSOIL	0	2
BROWN CLAY	2	29
GRAY CLAY	29	35
SANDY CLAY	35	37
GRAVEL	37	46
BLACK CLAY	46	48
GRAVEL	48	68
CLAY STOP	68	
(Use a second sheet if needed)		

10. Screen: Manufacturer's name 1255 PUMPCO
Type PIK Dia. 6"
Slot/gauze 416" Length 20'
Set between 47 ft. and 67 ft.
ft. and ft.
Gravel pack? Yes Size range of material 4 x 4

11. Static water level: mo./day/yr.
27 ft. below land surface Date 3/22/76

12. Pumping level below land surfaces:
___ ft. after 1 hrs. pumping ___ g.p.m.
___ ft. after ___ hrs. pumping ___ g.p.m.
Estimated maximum yield 100 g.p.m.

13. Water sample submitted: mo./day/yr.
___ Yes X No Date

14. Well head completion:
___ Pitless adapter X Inches above grade

15. Well grouted? Yes
With: X Neat cement ___ Bentonite ___ Concrete
Depth: From 0 ft. to 10 ft.

16. Nearest source of possible contamination:
ft. 200 Direction WEST Type SEPTIC
Well disinfected upon completion? X Yes ___ No

17. Pump: X Not installed
Manufacturer's name
Model number HP Volts
Length of drop pipe ft. capacity g.p.m.
Type:
___ Submersible ___ Turbine
___ Jet ___ Reciprocating
___ Centrifugal ___ Other

18. Elevation: 1360'
Topography:
___ Hill
___ Slope
X Upland
___ Valley

19. Remarks:

20. Water well contractor's certification:
This well was drilled under my jurisdiction and this report is true to the best of my knowledge and belief.
Geo Cox & Sons Inc 258
Business name License No.
Address GLETON, KANS
Signed Darryl Cox Date
Authorized representative 3/24/76

T 4 R 2 (E) (W) Sec 19 1/4 SE 1/4 NW 1/4 NE 1/4

Forward the white, blue and pink copies to the Department of Health and Environment

Form WWC-5