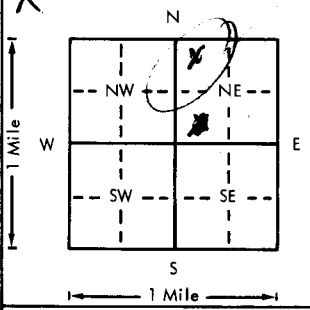


USE TYPEWRITER OR BALL
POINT PEN-PRESS FIRMLY,
PRINT CLEARLY.

WATER WELL RECORD
KSA 82a-1201-1215

Kansas Department of Health and
Environment-Division of Environment
(Water well Contractors)
Topeka, Kansas 66620

X Location of well: County <u>Republic</u>		X Section <u>N 1/4 N 1/4 E 1/4</u>		Section number <u>21</u>	Township number <u>T 4 S</u>	Range number <u>R 2 E</u>
X Distance and direction from nearest town or city: <u>15 miles agenda</u>				3. Owner of well: <u>R.D. Borchardt - marshland farm</u>		
Street address of well location if in city: <u>9</u>				R.R. or street: <u>Box 115 Route # 1</u>		
				City, state, zip code: <u>agenda, Kansas 666930</u>		
X Locate with "X" in section below:		Sketch map:		6. Bore hole dia. <u>8</u> in. Completion date <u>6-14-79</u>		
		<u>15 miles from agenda west & south</u>		Well depth <u>55</u> ft.		
5. Type and color of material				7. <u>X</u> Cable tool <u>X</u> Rotary <u> </u> Driven <u> </u> Dug <u> </u> <u> </u> Hollow rod <u> </u> Jetted <u> </u> Bored <u> </u> Reverse rotary		
<u>soil top</u> 1 2 <u>clay Gray</u> 2 11 <u>clay Brown</u> 11 23 <u>clay Black</u> 23 30 <u>clay Brown</u> 30 33 <u>sand med. fine red dirty</u> 33 47 <u>clay + sand rock</u> 47 50 <u>clay fine</u> 50 55				8. Use: <u>X</u> Domestic <u> </u> Public supply <u> </u> Industry <u> </u> <u> </u> Irrigation <u> </u> Air conditioning <u> </u> Stock <u> </u> <u> </u> Lawn <u> </u> Oil field water <u> </u> Other <u> </u>		
				9. Casing: Material <u>PVC</u> Height: Above or below Threaded <u> </u> Welded <u> </u> Surface <u>12</u> in. RMP <u> </u> PVC <u> </u> Weight <u>100</u> lbs./ft. Dia. <u>5</u> in. to <u>55</u> ft. depth Wall Thickness: inches or Dia. <u> </u> in. to <u> </u> ft. depth gage No. <u>200</u>		
				10. Screen: Manufacturer's name <u>Plastic</u> <u>4 FS approved</u> Type <u>Plastic</u> Dia. <u> </u> Slot/gauze <u>260</u> Length <u>20</u> Set between <u>35</u> ft. and <u>55</u> ft. Gravel pack? <u>Yes</u> Size range of material <u>Kalaguard</u>		
				11. Static water level: <u> </u> mo./day/yr. <u> </u> ft. below land surface Date <u>6-14-79</u>		
				12. Pumping level below land surfaces: <u> </u> ft. after <u> </u> hrs. pumping <u> </u> g.p.m. <u> </u> ft. after <u> </u> hrs. pumping <u> </u> g.p.m. Estimated maximum yield <u>15</u> g.p.m.		
				13. Water sample submitted: <u> </u> mo./day/yr. <u> </u> Yes <u>X</u> No Date <u> </u>		
				14. Well head completion: <u>Capped</u> <u> </u> Pitless adapter <u> </u> Inches above grade		
				15. Well grouted? <u>Yes</u> With: <u> </u> Neat cement <u> </u> Bentonite <u>X</u> Concrete <u> </u> Depth: From <u>0</u> ft. to <u>20</u> ft.		
				16. Nearest source of possible contamination: <u>None</u> ft. <u> </u> Direction <u> </u> Type <u> </u> Well disinfected upon completion? <u>X</u> Yes <u> </u> No		
				17. Pump: <u>X</u> Not installed Manufacturer's name <u> </u> Model number <u> </u> HP <u> </u> Volts <u> </u> Length of drop pipe <u> </u> ft. capacity <u> </u> g.p.m. Type: <u> </u> Submersible <u> </u> Turbine <u> </u> <u> </u> Jet <u> </u> Reciprocating <u> </u> <u> </u> Centrifugal <u> </u> Other <u> </u>		
(Use a second sheet if needed)						
18. Elevation: <u>1350'</u>		19. Remarks:		20. Water well contractor's certification: This well was drilled under my jurisdiction and this report is true to the best of my knowledge and belief. <u>Blue Valley Boring</u> 234 D Business name <u>Blue Valley Boring</u> License No. <u>66411</u> Address <u> </u> Signed <u> </u> Date <u>8-1-79</u> Authorized representative		