


~1/2 mi. E of Logan, Kansas

City, State, ZIP Code : Logan, KS 67646

submitted Water Well Disinfected? Yes No ☒

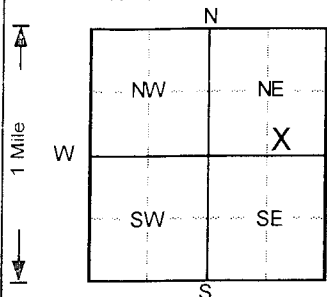

How many feet?

FROM	TO	LITHOLOGIC LOG	FROM	TO	PLUGGING INTERVALS
0	5.5	Silt, w/tr. clay and sand, Brown			
5.5	10	Silt, sandy, w/tr. clay, Brown			
10	16.5	Sand, f-m, w/tr. clay, Lt. Brown			
16.5	20.5	Sand, f-c, w/f-m gravel, tr. clay, Lt. Brown			
20.5	21	Shale, wthrd. grading to firm, Gray			
					MWR-1

INSTRUCTIONS: Use typewriter or ball point pen. PLEASE PRESS FIRMLY and PRINT clearly. Please fill in blanks, underline or circle the correct answers. Send top three copies to Kansas Department of Health and Environment, Bureau of Water, Topeka, Kansas 66620-0001. Telephone: 913-296-5545. Send one to WATER WELL OWNER and retain one for your records.