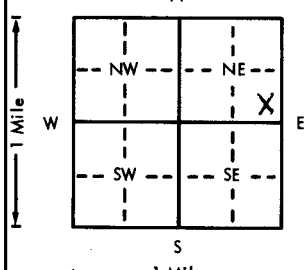
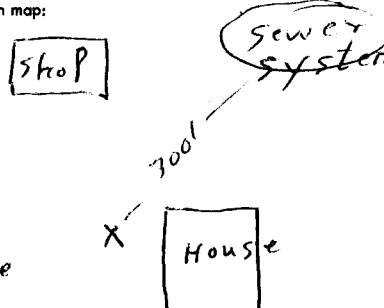


USE TYPEWRITER OR BALL
POINT PEN-PRESS FIRMLY,
PRINT CLEARLY.

WATER WELL RECORD
KSA 82a-1201-1215

Kansas Department of Health and
Environment-Division of Environment
(Water well Contractors)
Topeka, Kansas 66620

1. Location of well:		County <u>Norton</u>	Fraction <u>SE 1/4</u> <u>SE 1/4</u> <u>NE 1/4</u>	Section number <u>6</u>	Township number <u>T 4</u> <u>S</u>	Range number <u>R 21 W</u> <u>E/W</u>
2. Distance and direction from nearest town or city: Street address of well location if in city: <u>9 East 6 1/2 South of Norton, Ks.</u>			3. Owner of well: <u>Wayne Underwood</u> R.R. or street: City, state, zip code: <u>Almena, Kansas 67622</u>			
4. Locate with "X" in section below:		Sketch map:		6. Bore hole dia. <u>9</u> in. Completion date <u>3/10/76</u> Well depth <u>97</u> ft.		
				7. <input checked="" type="checkbox"/> Cable tool <input checked="" type="checkbox"/> Rotary <input type="checkbox"/> Driven <input type="checkbox"/> Dug <input type="checkbox"/> Hollow rod <input type="checkbox"/> Jetted <input type="checkbox"/> Bored <input type="checkbox"/> Reverse rotary		
5. Type and color of material		From		To		8. Use: <input checked="" type="checkbox"/> Domestic <input type="checkbox"/> Public supply <input type="checkbox"/> Industry <input type="checkbox"/> Irrigation <input type="checkbox"/> Air conditioning <input type="checkbox"/> Stock <input type="checkbox"/> Lawn <input type="checkbox"/> Oil field water <input type="checkbox"/> Other
<u>Clay</u>		<u>0</u>		<u>30</u>		9. Casing: Material <u>Plas</u> Height: Above or below Threaded <input type="checkbox"/> Welded <input type="checkbox"/> Surface <u>14</u> in. RMP <input checked="" type="checkbox"/> PVC <input type="checkbox"/> Weight <u>180</u> lbs./ft. Dia. <u>5</u> in. to <u>77</u> ft. depth Wall Thickness: inches or Dia. <u>5</u> in. to <u>77</u> ft. depth gage No. <u>250</u>
<u>Clay + Lime Rock. v. H.</u>		<u>30</u>		<u>56</u>		10. Screen: Manufacturer's name <u>Modern Pipe</u> Type <u>PVC</u> Dia. <u>5</u> Slot/gauze <u>.032</u> Length <u>20'</u> Set between <u>77</u> ft. and <u>97</u> ft. ft. and <u>97</u> ft. Gravel pack? <u>Yes</u> Size range of material <u>5 x 1/8</u>
<u>Sand + Gravel with clay</u>		<u>36</u>		<u>63</u>		11. Static water level: <u>72</u> ft. below land surface Date <u>2/13/76</u> mo./day/yr.
<u>Lime Rock</u>		<u>63</u>		<u>72</u>		12. Pumping level below land surfaces: ft. after <u> </u> hrs. pumping <u> </u> g.p.m. ft. after <u> </u> hrs. pumping <u> </u> g.p.m. Estimated maximum yield <u>7</u> g.p.m.
<u>Sand Rock + Lime (white)</u>		<u>72</u>		<u>98</u>		13. Water sample submitted: <u> </u> mo./day/yr. Yes <input checked="" type="checkbox"/> No <input type="checkbox"/> Date <u> </u>
<u>BRICK ?</u>		<u> </u>		<u> </u>		14. Well head completion: <input checked="" type="checkbox"/> Pitless adapter <u>14"</u> Inches above grade
<u> </u>		<u> </u>		<u> </u>		15. Well grouted? <u>Yes</u> With: <u> </u> Neat cement <u> </u> Bentonite <input checked="" type="checkbox"/> Concrete Depth: From <u>18</u> ft. to <u>4</u> ft.
<u> </u>		<u> </u>		<u> </u>		16. Nearest source of possible contamination: ft. <u>300</u> Direction <u>NE</u> Type <u>Sewer</u> Well disinfected upon completion? <input checked="" type="checkbox"/> Yes <input type="checkbox"/> No
<u> </u>		<u> </u>		<u> </u>		17. Pump: Manufacturer's name <u>Aermotor</u> Not installed Model number <u>SD5-37</u> HP <u>3</u> Volts <u>270</u> Length of drop pipe <u>56</u> ft. capacity <u>5</u> g.p.m. Type: <input checked="" type="checkbox"/> Submersible <input type="checkbox"/> Turbine <input type="checkbox"/> Jet <input type="checkbox"/> Reciprocating <input type="checkbox"/> Centrifugal <input type="checkbox"/> Other
18. Elevation: <u>2320</u>		19. Remarks:		20. Water well contractor's certification: This well was drilled under my jurisdiction and this report is true to the best of my knowledge and belief. <u>John R. Fawcett & son</u> <u>167</u> Business name <u>Norton Kansas</u> License No. <u>67654</u> Address <u>John R. Fawcett</u> Date <u> </u> Signed <u>John R. Fawcett</u> Authorized representative		