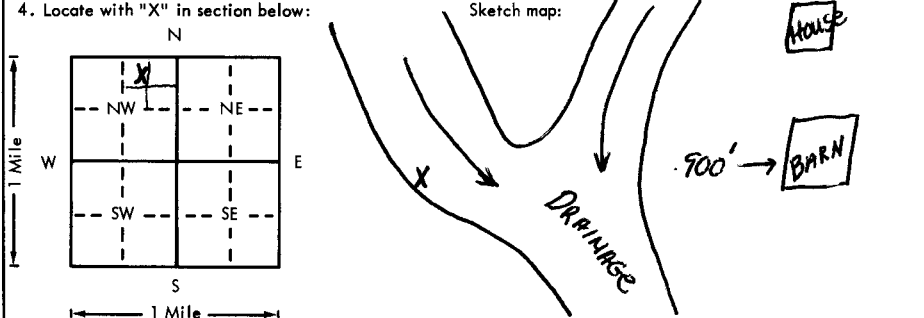


USE TYPEWRITER OR BALL
POINT PEN-PRESS FIRMLY,
PRINT CLEARLY.

WATER WELL RECORD
KSA 82a-1201-1215

Kansas Department of Health and
Environment-Division of Environment
(Water well Contractors)
Topeka, Kansas 66620

1. Location of well:	County Norton	Fraction NW 1/4 NE 1/4 NW 1/4	Section number 13	Township number T 4 S R 21	Range number #W
2. Distance and direction from nearest town or city: From Logan 1 mile west on Hwy 9, 3 mile north & 2 1/2 west			3. Owner of well: Marie Boyd & Betty Townsend R.R. or street: 451 3rd St. City, state, zip code: Phillipsburg, Ks. 67661		
4. Locate with "X" in section below: 			6. Bore hole dia. 9 1/2 in. Completion date: 10-29-77 Well depth 23 ft.		
5. Type and color of material			7. <input checked="" type="checkbox"/> Cable tool <input type="checkbox"/> Rotary <input type="checkbox"/> Driven <input type="checkbox"/> Dug <input type="checkbox"/> Hollow rod <input type="checkbox"/> Jetted <input type="checkbox"/> Bored <input type="checkbox"/> Reverse rotary		
			8. Use: <input type="checkbox"/> Domestic <input type="checkbox"/> Public supply <input type="checkbox"/> Industry <input type="checkbox"/> Irrigation <input type="checkbox"/> Air conditioning <input checked="" type="checkbox"/> Stock <input type="checkbox"/> Lawn <input type="checkbox"/> Oil field water <input type="checkbox"/> Other		
Top Soil			9. Casing: Material <input type="checkbox"/> Height: Above or below ground Threaded <input type="checkbox"/> Welded <input type="checkbox"/> Surface 24 in. RMP <input type="checkbox"/> PVC <input checked="" type="checkbox"/> Weight <input type="checkbox"/> lbs./ft. Dia. 6 in. to 23 ft. depth Wall Thickness: inches or Dia. <input type="checkbox"/> in. to <input type="checkbox"/> ft. depth gage No. 255		
			10. Screen: Manufacturer's name Robintech Type PVC Dia. 6" Slot/gauze 1/8" Length 10' Set between 13 ft. and 23 ft. Gravel pack? yes Size range of material 1/8" minus		
Sandy Clay			11. Static water level: <input type="checkbox"/> mo./day/yr. 12 ft. below land surface Date 10-29-77		
Fine Sand			12. Pumping level below land surfaces: ____ ft. after ____ hrs. pumping ____ g.p.m. ____ ft. after ____ hrs. pumping ____ g.p.m. Estimated maximum yield 8 g.p.m.		
Coarse Sand & Flint Rock			13. Water sample submitted: <input type="checkbox"/> mo./day/yr. Yes <input checked="" type="checkbox"/> No Date _____		
Shale			14. Well head completion: ____ Pitless adapter 24 inches above grade		
BROCK 20' 20			15. Well grouted? Yes With: <input type="checkbox"/> Neat cement <input checked="" type="checkbox"/> Bentonite <input type="checkbox"/> Concrete Depth: From 0 ft. to 10 ft.		
fu 12' 8' set thick			16. Nearest source of possible contamination: ft. 900 Direction East Type Barn Well disinfected upon completion? <input type="checkbox"/> Yes <input checked="" type="checkbox"/> No		
not in Cg			17. Pump: <input checked="" type="checkbox"/> Not installed Manufacturer's name _____ Model number _____ HP _____ Volts _____ Length of drop pipe _____ ft. capacity _____ g.p.m. Type: <input type="checkbox"/> Submersible <input type="checkbox"/> Turbine <input type="checkbox"/> Jet <input type="checkbox"/> Reciprocating <input type="checkbox"/> Centrifugal <input type="checkbox"/> Other		
(Use a second sheet if needed)			20. Water well contractor's certification: This well was drilled under my jurisdiction and this report is true to the best of my knowledge and belief. Deer Drilling 3/4/4 Business name Rt 4 Phillipsburg, Ks. License No. _____ Address William J. Deer Date 11-3-77 Signed _____ Authorized representative		
18. Elevation: Topography: <input type="checkbox"/> Hill <input type="checkbox"/> Slope <input type="checkbox"/> Upland <input checked="" type="checkbox"/> Valley	19. Remarks: 2100 2000				