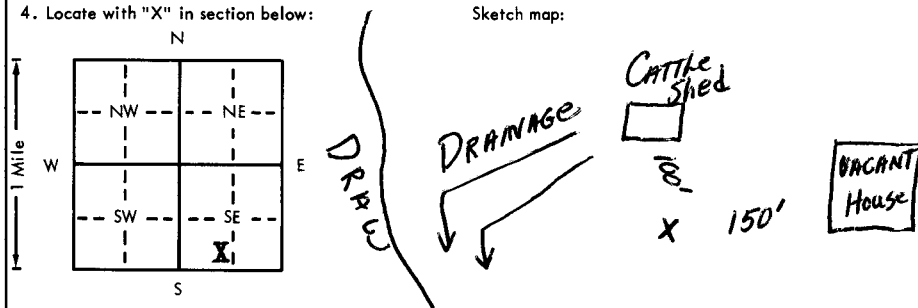


USE TYPEWRITER OR BALL  
POINT PEN-PRESS FIRMLY,  
PRINT CLEARLY.

WATER WELL RECORD  
KSA 82a-1201-1215

Kansas Department of Health and  
Environment-Division of Environment  
(Water well Contractors)  
Topeka, Kansas 66620

1. Location of well:	County <b>Norton</b>	Fraction <b>SE 1/4 SW 1/4 SE 1/4</b>	Section number <b>27</b>	Township number <b>T 4 S</b>	Range number <b>R 21 W</b>
2. Distance and direction from nearest town or city: <b>From Logan, 5 Mi. west 1 Mi. north and 1/2 Mi. west on north side of Rd.</b>			3. Owner of well: <b>Pauline Petzold</b> R.R. or street: City, state, zip code: <b>Logan, Kansas</b>		
4. Locate with "X" in section below: 			6. Bore hole dia. <b>9 1/8</b> in. Completion date <b>4-1-78</b> Well depth <b>55</b> ft.		
			7. <input checked="" type="checkbox"/> Cable tool <input type="checkbox"/> Rotary <input type="checkbox"/> Driven <input type="checkbox"/> Dug <input type="checkbox"/> Hollow rod <input type="checkbox"/> Jetted <input type="checkbox"/> Bored <input type="checkbox"/> Reverse rotary		
			8. Use: <input type="checkbox"/> Domestic <input type="checkbox"/> Public supply <input type="checkbox"/> Industry <input type="checkbox"/> Irrigation <input type="checkbox"/> Air conditioning <input checked="" type="checkbox"/> Stock <input type="checkbox"/> Lawn <input type="checkbox"/> Oil field water <input type="checkbox"/> Other		
			9. Casing: Material <input type="checkbox"/> Height: Above or <input type="checkbox"/> Below Threaded <input type="checkbox"/> Welded <input type="checkbox"/> Surface <b>2 1/4</b> in. RMP <input type="checkbox"/> PVC <input checked="" type="checkbox"/> Weight <input type="checkbox"/> lbs./ft. Dia. <b>6</b> in. to <b>55</b> ft. depth Wall Thickness: inches or Dia. <input type="checkbox"/> in. to <input type="checkbox"/> ft. depth gage No. <b>.255</b>		
5. Type and color of material			From	To	10. Screen: Manufacturer's name <b>Robintech</b>
<b>Top Soil</b>			<b>0</b>	<b>8</b>	Type <b>PVC</b> Dia. <b>6</b> in.
<b>Sandy Clay - Light Yellow</b>			<b>8</b>	<b>41</b>	Slot/gauze <b>1/8</b> in. Length <b>10</b> ft.
<b>Chalk Rock</b>			<b>41</b>	<b>42</b>	Set between <b>45</b> ft. and <b>55</b> ft.
<b>Fine Sand - Some Flint</b>			<b>42</b>	<b>52</b>	<input type="checkbox"/> ft. and <input type="checkbox"/> ft.
<b>Grey Shale</b>			<b>52</b>	<b>55</b>	Gravel pack? <b>yes</b> Size range of material <b>3/4 minus</b>
<b>BROCK</b>					11. Static water level: <input type="checkbox"/> mo./day/yr. <b>40</b> ft. below land surface Date <b>4-1-78</b>
					12. Pumping level below land surfaces: <input type="checkbox"/> ft. after <input type="checkbox"/> hrs. pumping <input type="checkbox"/> g.p.m. <input type="checkbox"/> ft. after <input type="checkbox"/> hrs. pumping <input type="checkbox"/> g.p.m. Estimated maximum yield <b>8</b> g.p.m.
					13. Water sample submitted: <input type="checkbox"/> mo./day/yr. <input type="checkbox"/> Yes <input checked="" type="checkbox"/> No Date
					14. Well head completion: <input type="checkbox"/> Pitless adapter <b>2 1/4</b> inches above grade
					15. Well grouted? <b>yes</b> With: <input type="checkbox"/> Neat cement <input checked="" type="checkbox"/> Bentonite <input type="checkbox"/> Concrete Depth: From <b>0</b> ft. to <b>21</b> ft.
					16. Nearest source of possible contamination: ft. <b>100</b> Direction <b>north</b> Type <b>Cattle</b> Well disinfected upon completion? <input type="checkbox"/> Yes <input checked="" type="checkbox"/> No
					17. Pump: <input checked="" type="checkbox"/> Not installed Manufacturer's name Model number <input type="checkbox"/> HP <input type="checkbox"/> Volts Length of drop pipe <input type="checkbox"/> ft. capacity <input type="checkbox"/> g.p.m. Type: <input type="checkbox"/> Submersible <input type="checkbox"/> Turbine <input type="checkbox"/> Jet <input type="checkbox"/> Reciprocating <input type="checkbox"/> Centrifugal <input type="checkbox"/> Other
					20. Water well contractor's certification: This well was drilled under my jurisdiction and this report is true to the best of my knowledge and belief. <b>Deer Drilling</b> <b>344</b> Business name <b>Rt 4 Phillipsburg, Ks.</b> License No. Address <b>William J. Deer</b> <b>4-1-78</b> Signed <b>William J. Deer</b> Date <b>4-1-78</b> Authorized representative
18. Elevation:			19. Remarks: <b>2062</b>		
Topography: <input type="checkbox"/> Hill <input type="checkbox"/> Slope <input checked="" type="checkbox"/> Upland <input type="checkbox"/> Valley					