


1 LOCATION OF WATER WELL: Fraction $\frac{1}{4}$ $\frac{1}{4}$ W $1\frac{1}{2}$ Section Number 22 Township Number T 4 S Range Number R 23 EW

Distance and direction from nearest town or city street address of well if located within city?
 10 miles south 1/2 west, 1/2 north of Norton, Ks. 67654

2 WATER WELL OWNER: Paul Becker
 RR#, St. Address, Box #: RR 3 Box 57
 City, State, ZIP Code: Norton, Ks. 67654
 Board of Agriculture, Division of Water Resources
 Application Number:

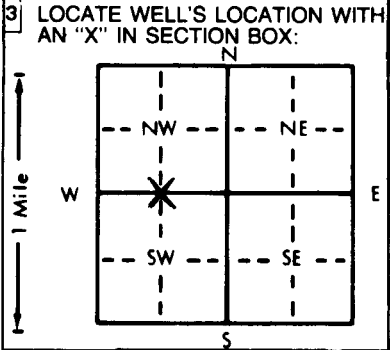

4 DEPTH OF COMPLETED WELL... 205 ft. ELEVATION:
 Depth(s) Groundwater Encountered 1. ft. 2. ft. 3. ft.
 WELL'S STATIC WATER LEVEL... 125 ft. below land surface measured on mo/day/yr
 Pump test data: Well water was ft. after hours pumping gpm
 Est. Yield gpm: Well water was ft. after hours pumping gpm
 Bore Hole Diameter. 8 in. to 205 ft., and in. to ft.
 WELL WATER TO BE USED AS:
 1 Domestic 3 Feedlot 5 Public water supply 6 Oil field water supply 8 Air conditioning 9 Dewatering 10 Monitoring well 11 Injection well 12 Other (Specify below)
 2 Irrigation 4 Industrial 7 Lawn and garden only
 Was a chemical/bacteriological sample submitted to Department? Yes. No. ; If yes, mo/day/yr sample was submitted
 Water Well Disinfected? Yes No

5 TYPE OF BLANK CASING USED:
 1 Steel 2 PVC 3 RMP (SR) 4 ABS 5 Wrought iron 6 Asbestos-Cement 7 Fiberglass 8 Concrete tile 9 Other (specify below) CASING JOINTS: Glued Clamped
 Blank casing diameter 4.5 in. to 165 ft., Dia. in. to ft., Dia. in. to ft.
 Casing height above land surface 18 in., weight 2.38 lbs./ft. Wall thickness or gauge No. 248
 TYPE OF SCREEN OR PERFORATION MATERIAL:
 1 Steel 2 Brass 3 Stainless steel 4 Galvanized steel 5 Fiberglass 6 Concrete tile 7 PVC 8 RMP (SR) 9 ABS 10 Asbestos-cement 11 Other (specify)
 SCREEN OR PERFORATION OPENINGS ARE:
 1 Continuous slot 2 Louvered shutter 3 Mill slot 4 Key punched 5 Gauzed wrapped 6 Wire wrapped 7 Torch cut 8 Saw cut 9 Drilled holes 11 None (open hole)
 SCREEN-PERFORATED INTERVALS: From 165 ft. to 205 ft., From ft. to ft.
 GRAVEL PACK INTERVALS: From 20 ft. to 205 ft., From ft. to ft.

6 GROUT MATERIAL: 1 Neat cement 2 Cement grout 3 Bentonite 4 Other
 Grout Intervals: From 0 ft. to 20 ft., From ft. to ft., From ft. to ft.
 What is the nearest source of possible contamination: None
 1 Septic tank 2 Sewer lines 3 Watertight sewer lines 4 Lateral lines 5 Cess pool 6 Seepage pit 7 Pit privy 8 Sewage lagoon 9 Feedyard 10 Livestock pens 11 Fuel storage 12 Fertilizer storage 13 Insecticide storage 14 Abandoned water well 15 Oil well/Gas well 16 Other (specify below)

Direction from well? How many feet?

FROM	TO	LITHOLOGIC LOG	FROM	TO	PLUGGING INTERVALS
0	3	Surface	108	116	Sticky Clay
3	15	Yellow Clay	116	130	Sandstone & Clay
15	31	Caliche Clay & Sandstone Strks	130	132	Fine to Medium Sand
31	33	Clay	132	139	Sandy Clay & Fine Sand
33	44	Caliche Sandstone & Clay Strks	139	148	Fine Sand w/ Clay Strks.
44	64	Clay & Caliche	148	194	Fine to Med. Sand w/Clay Str
64	69	Med. Sand	194	200	Sandy Clay
69	71	Clay	200	205	Clay & Fine Sand Strks.
71	78	Med. Sand			
78	79	Clay			
79	95	Med Sand			
95	95.5	Caliche			
95.5	100	Med. Sand			
100	103	Sand			
103	108	Sand, Clay & Caliche Strks.			

7 CONTRACTOR'S OR LANDOWNER'S CERTIFICATION: This water well was (1) constructed, (2) reconstructed, or (3) plugged under my jurisdiction and was completed on (mo/day/year) 3-17-93 and this record is true to the best of my knowledge and belief. Kansas Water Well Contractor's License No. 554 This Water Well Record was completed on (mo/day/yr) 3-18-93 under the business name of WOOFER PUMP & WELL, INC. by (signature) Gary C. Wofter