

USE TYPEWRITER OR BALL POINT PEN-PRESS FIRMLY, PRINT CLEARLY.


Clayton me

DBB
WATER WELL RECORD
KSA 82a-1201-1215

Kansas Department of Health and Environment-Division of Environment
(Water well Contractors)
Topeka, Kansas 66620

1. Location of well: County Norton Section NW 1/4 1/4 1/4 Section number 9 Township number T 4 S Range number R 24W E/W

2. Distance and direction from nearest town or city: 7 1/2 south 1 1/2 west of Norton
Street address of well location if in city: KANSAS
3. Owner of well: Warren Harting
R.R. or street: Rt 3
City, state, zip code: Norton Kansas 67654

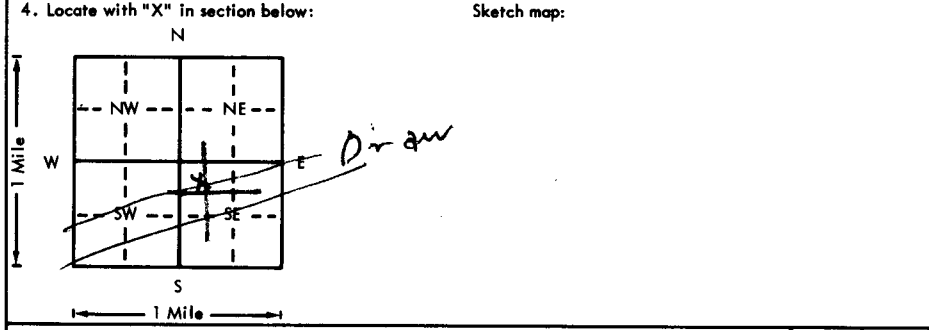

6. Bore hole dia. 9 in. Completion date 4/23/76
Well depth 130 ft.
7. Cable tool Rotary Driven Dug
 Hollow rod Jetted Bored Reverse rotary
8. Use: Domestic Public supply Industry
 Irrigation Air conditioning Stock
 Lawn Oil field water Other
9. Casing: Material PT5 Height Above or below
Threaded Welded Surface 12 in.
RMP PVC Weight 280 lbs./ft.
Dia. 5 in. to 190 ft. depth; Wall Thickness: inches or
Dia. in. to ft. depth; gage No. 250

5. Type and color of material	From	To
<u>Black clay</u>	<u>0</u>	<u>4</u>
<u>Sand, medium to fine</u>	<u>4</u>	<u>21</u>
<u>Clay, Green & Sandy</u>	<u>21</u>	<u>52</u>
<u>Clay, Brown & Sandy</u>	<u>52</u>	<u>70</u>
<u>Sand, medium size</u>	<u>70</u>	<u>73</u>
<u>Clay, Red & Sandy</u>	<u>73</u>	<u>110</u>
<u>Fine sand & sand stone</u>	<u>110</u>	<u>130</u>
<u>BROCK ?</u>		

10. Screen: Manufacturer's name Medora Pipe INIA
Type PVC Dia. 5
Slot/gauze Slot Length 20
Set between 100 ft. and 130 ft.
Gravel pack? Yes Size range of material 1/4 x 1/2 ft.
11. Static water level: 100 ft. below land surface Date 4/23/76 mo./day/yr.
12. Pumping level below land surfaces:
 ft. after hrs. pumping g.p.m.
 ft. after hrs. pumping g.p.m.
Estimated maximum yield 18 GPM g.p.m.
13. Water sample submitted: mo./day/yr.
Yes No Date
14. Well head completion: JTL well head
 Pitless adapter 12 inches above grade
15. Well grouted? Yes
With: Neat cement Bentonite Concrete
Depth: From 27 ft. to 10 ft.
16. Nearest source of possible contamination: None
ft. Direction Type None
Well disinfected upon completion? Yes No
17. Pump: Not installed
Manufacturer's name Aermator Co
Model number SDS-33 HP 15 Volts 270
Length of drop pipe 126 ft. capacity 5 g.p.m.
Type: Submersible Turbine
 Jet Reciprocating
 Centrifugal Other

18. Elevation: 2503
19. Remarks: 2503
Topography:
 Hill
 Slope
 Upland
 Valley

20. Water well contractor's certification:
This well was drilled under my jurisdiction and this report is true to the best of my knowledge and belief.
John R. Fawcett & Son 167
Business name License No.
Address Norton Kansas
Signed John R. Fawcett Date 4/27/76
Authorized representative

T 7
R 78
E 7
S 9
1/4 1/4 1/4
55015E