

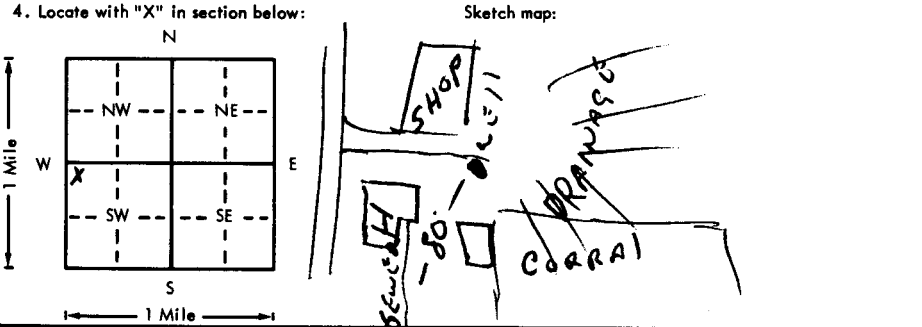
USE TYPEWRITER OR BALL POINT PEN-PRESS FIRMLY, PRINT CLEARLY.

WATER WELL RECORD
KSA 82a-1201-1215

Kansas Department of Health and Environment-Division of Environment
(Water well Contractors)
Topeka, Kansas 66620

Clinton me

CRB

1. Location of well:		County NORTON	Fraction NW1/4 NW1/4 SW1/4	Section number 26	Township number T 4 S	Range number R 24 E/W
2. Distance and direction from nearest town or city: 4 miles NORTH of LENORA Street address of well location if in city: KS.				3. Owner of well: Richard HEIKES R.R. or street: LENORA, KS 67645 City, state, zip code:		
4. Locate with "X" in section below: 				6. Bore hole dia. 9 in. Completion date 8/16/76 Well depth 170 ft.		
5. Type and color of material				7. <input checked="" type="checkbox"/> Cable tool <input checked="" type="checkbox"/> Rotary <input type="checkbox"/> Driven <input type="checkbox"/> Dug <input type="checkbox"/> Hollow rod <input type="checkbox"/> Jetted <input type="checkbox"/> Bored <input type="checkbox"/> Reverse rotary		
				8. Use: <input checked="" type="checkbox"/> Domestic <input type="checkbox"/> Public supply <input type="checkbox"/> Industry <input type="checkbox"/> Irrigation <input type="checkbox"/> Air conditioning <input type="checkbox"/> Stock <input type="checkbox"/> Lawn <input type="checkbox"/> Oil field water <input type="checkbox"/> Other		
				9. Casing: Material RASIT Height Above or below Threaded <input type="checkbox"/> Welded <input type="checkbox"/> Surface 12 in. RMP <input checked="" type="checkbox"/> PVC <input type="checkbox"/> Weight 190 lbs./ft. Dia. 5 in. to 110 ft. depth Wall Thickness: inches or Dia. <input type="checkbox"/> in. to <input type="checkbox"/> ft. depth gage No. 250		
				10. Screen: Manufacturer's name M.P.T. Type PVC Dia. 5" Slot/haule .032 Length 20 Set between 110 ft. and 130 ft. ft. and <input type="checkbox"/> ft. Gravel pack? YES Size range of material 1/4 x 3/4		
				11. Static water level: <input type="checkbox"/> mo./day/yr. 103 ft. below land surface Date 8/14/76		
				12. Pumping level below land surfaces: ____ ft. after ____ hrs. pumping ____ g.p.m. ____ ft. after ____ hrs. pumping ____ g.p.m. Estimated maximum yield 9 GPM g.p.m.		
				13. Water sample submitted: <input type="checkbox"/> mo./day/yr. Yes <input checked="" type="checkbox"/> No Date _____		
				14. Well head completion: <input checked="" type="checkbox"/> Pitless adapter 12 inches above grade		
				15. Well grouted? YES With: <input type="checkbox"/> Neat cement <input checked="" type="checkbox"/> Bentonite <input type="checkbox"/> Concrete Depth: From 5 ft. to 15 ft.		
				16. Nearest source of possible contamination: ft. 20' Direction S Type sewer Well disinfected upon completion? <input checked="" type="checkbox"/> Yes <input type="checkbox"/> No		
				17. Pump: <input type="checkbox"/> Not installed Manufacturer's name AER motor Model number SDP150 HP 1/2 Volts 230 Length of drop pipe 125' ft. capacity 8 g.p.m. Type: <input checked="" type="checkbox"/> Submersible <input type="checkbox"/> Turbine <input type="checkbox"/> Jet <input type="checkbox"/> Reciprocating <input type="checkbox"/> Centrifugal <input type="checkbox"/> Other		
18. Elevation: Topography: <input type="checkbox"/> Hill <input type="checkbox"/> Slope <input checked="" type="checkbox"/> Upland <input type="checkbox"/> Valley				19. Remarks: 2440		
				20. Water well contractor's certification: This well was drilled under my jurisdiction and this report is true to the best of my knowledge and belief. Fawcett & Son 167 Business name License No. Address Norton KS. Signed [Signature] Date 8/30/76 Authorized representative		

T 4 S
 R 24 E/W
 Sec 26
 NW 1/4