

USE TYPEWRITER OR BALL POINT PEN-PRESS FIRMLY, PRINT CLEARLY.

*Admond new*


WATER WELL RECORD  
KSA 82a-1201-1215

Kansas Department of Health and Environment-Division of Environment (Water well Contractors) Topeka, Kansas 66620

*BDE*

1. Location of well: County Norton Fraction SE 1/4 SE 1/4 NW 1/4 Section number 36 Township number T 4 S R 24 *W*

2. Distance and direction from nearest town or city: 4 North 1 1/2 East of Lenora KS. Street address of well location if in city: KS.  
3. Owner of well: Louis Thomas  
R.R. or street: RR #3  
City, state, zip code: Norton KS 67654.

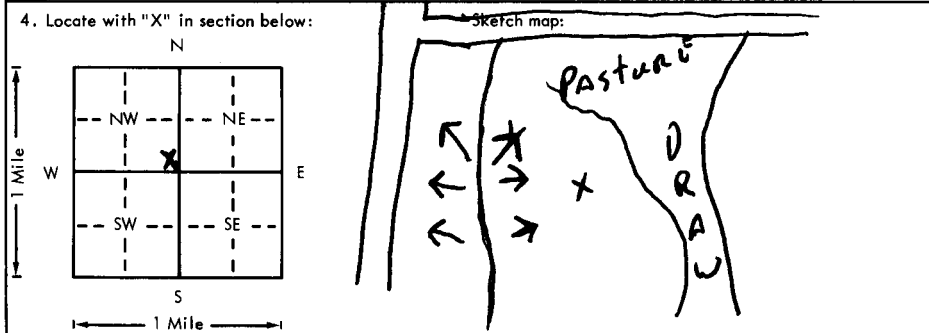

6. Bore hole dia. 9 in. Completion date 5-11-77  
Well depth 130 ft.  
7.  Cable tool  Rotary  Driven  Dug  
 Hollow rod  Jetted  Bored  Reverse rotary  
8. Use:  Domestic  Public supply  Industry  
 Irrigation  Air conditioning  Stock  
 Lawn  Oil field water  Other  
9. Casing: Material \_\_\_\_\_ Height Above or below  
Threaded \_\_\_\_\_ Welded \_\_\_\_\_ Surface 12 in.  
RMP \_\_\_\_\_ PVC  Weight 275 lbs./ft.  
Dia. 5 in. to 110 ft. depth Wall Thickness: inches or  
Dia. \_\_\_\_\_ in. to \_\_\_\_\_ ft. depth Gage No. 258

5. Type and color of material	From	To
<u>Clay Black.</u>	<u>0</u>	<u>4</u>
<u>Clay Tan</u>	<u>4</u>	<u>15</u>
<u>SAND &amp; SANDY CLAY</u>	<u>15</u>	<u>127</u>
<u>White Rock.</u>	<u>127</u>	<u>130</u>
<u>BROCK ?</u>		

10. Screen: Manufacturer's name MODERN PIPES INC.  
Type PVC Dia. 5"  
Slot/gauze 033 Length 20'  
Set between 110 ft. and 130 ft.  
ft. and \_\_\_\_\_ ft.  
Gravel pack?  YES Size range of material 10-14  
11. Static water level: \_\_\_\_\_ mo./day/yr.  
98 ft. below land surface Date 5-11-77  
12. Pumping level below land surfaces:  
\_\_\_\_\_ ft. after \_\_\_\_\_ hrs. pumping \_\_\_\_\_ g.p.m.  
\_\_\_\_\_ ft. after \_\_\_\_\_ hrs. pumping \_\_\_\_\_ g.p.m.  
Estimated maximum yield 10 g.p.m.  
13. Water sample submitted: \_\_\_\_\_ mo./day/yr.  
 Yes  No Date \_\_\_\_\_  
14. Well head completion:  
 Pitless adapter 12 inches above grade  
15. Well grouted?  YES  
With:  Neat cement  Bentonite  Concrete  
Depth: From 0 ft. to 20 ft.  
16. Nearest source of possible contamination: Run  
ft. 200 Direction WEST Type OFF  
Well disinfected upon completion?  Yes  No  
17. Pump:  Not installed  
Manufacturer's name \_\_\_\_\_ HP \_\_\_\_\_ Volts \_\_\_\_\_  
Model number \_\_\_\_\_ Length of drop pipe \_\_\_\_\_ ft. capacity \_\_\_\_\_ g.p.m.  
Type:  
 Submersible  Turbine  
 Jet  Reciprocating  
 Centrifugal  Other

18. Elevation: \_\_\_\_\_  
19. Remarks: 2420  
Topography:  Hill  
 Slope  
 Upland  
 Valley

20. Water well contractor's certification:  
This well was drilled under my jurisdiction and this report is true to the best of my knowledge and belief.  
FAWCETT & SON 167  
Business name License No.  
Address Box 149, Norton KS  
Signed Al Fawcett Date 8/24/77  
Authorized representative

T 4  
R 24  
E W  
S 6  
SE SE NW  
1/4 1/4 1/4