


1 LOCATION OF WATER WELL: Fraction Section Number Township Number Range Number  
 County: Norton SE 1/4 SE 1/4 NE 1/4 6 T 4 S R 24 **EW**

Distance and direction from nearest town or city street address of well if located within city?  
 6 miles East 1/2 Mile South of Clayton

2 WATER WELL OWNER: Brock Ellis  
 RR#, St. Address, Box # : Rt. 3 Board of Agriculture, Division of Water Resources  
 City, State, ZIP Code : Norton, Ks. 67654 Application Number:

3 LOCATE WELL'S LOCATION WITH AN "X" IN SECTION BOX:

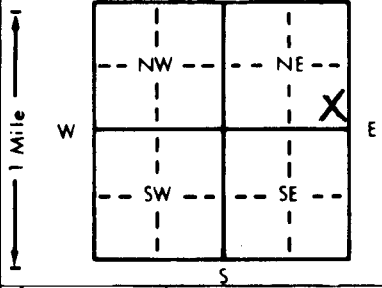

4 DEPTH OF COMPLETED WELL 154 ft. ELEVATION:  
 Depth(s) Groundwater Encountered 1. . . . . ft. 2. . . . . ft. 3. . . . . ft.  
 WELL'S STATIC WATER LEVEL 104 ft. below land surface measured on mo/day/yr  
 Pump test data: Well water was . . . . . ft. after . . . . . hours pumping . . . . . gpm  
 Est. Yield . . . . . gpm: Well water was . . . . . ft. after . . . . . hours pumping . . . . . gpm  
 Bore Hole Diameter 8 in. to 154 ft. and . . . . . in. to . . . . . ft.  
 WELL WATER TO BE USED AS:  
 5 Public water supply 8 Air conditioning 11 Injection well  
 1 Domestic 3 Feedlot 6 Oil field water supply 9 Dewatering 12 Other (Specify below)  
 2 Irrigation 4 Industrial 7 Lawn and garden only 10 Monitoring well . . . . .  
 Was a chemical/bacteriological sample submitted to Department? Yes . . . . . No **X**; If yes, mo/day/yr sample was sub-  
 mitted Water Well Disinfected? Yes No **X**

5 TYPE OF BLANK CASING USED:  
 1 Steel 3 RMP (SR) 5 Wrought iron 8 Concrete tile CASING JOINTS: Glued **X** Clamped . . . . .  
 2 PVC 4 ABS 6 Asbestos-Cement 9 Other (specify below) Welded . . . . .  
 7 Fiberglass Threaded . . . . .  
 Blank casing diameter 4.5 in. to 114 ft. Dia . . . . . in. to . . . . . ft. Dia . . . . . in. to . . . . . ft.  
 Casing height above land surface 18 in. weight 2.38 lbs./ft. Wall thickness or gauge No. 248  
 TYPE OF SCREEN OR PERFORATION MATERIAL:  
 1 Steel 3 Stainless steel 5 Fiberglass 7 PVC 10 Asbestos-cement  
 2 Brass 4 Galvanized steel 6 Concrete tile 8 RMP (SR) 11 Other (specify) . . . . .  
 9 ABS 12 None used (open hole)  
 SCREEN OR PERFORATION OPENINGS ARE:  
 1 Continuous slot 3 Mill slot 5 Gauzed wrapped 8 Saw cut 11 None (open hole)  
 2 Louvered shutter 4 Key punched 6 Wire wrapped 9 Drilled holes  
 7 Torch cut 10 Other (specify) . . . . .  
 SCREEN-PERFORATED INTERVALS: From 114 ft. to 154 ft. From . . . . . ft. to . . . . . ft.  
 From . . . . . ft. to . . . . . ft. From . . . . . ft. to . . . . . ft.  
 GRAVEL PACK INTERVALS: From 20 ft. to 154 ft. From . . . . . ft. to . . . . . ft.  
 From . . . . . ft. to . . . . . ft. From . . . . . ft. to . . . . . ft.

6 GROUT MATERIAL: 1 Neat cement 2 Cement grout 3 Bentonite 4 Other . . . . .  
 Grout Intervals: From 0 ft. to 20 ft. From . . . . . ft. to . . . . . ft. From . . . . . ft. to . . . . . ft.  
 What is the nearest source of possible contamination:  
 1 Septic tank 4 Lateral lines 7 Pit privy 10 Livestock pens 14 Abandoned water well  
 2 Sewer lines 5 Cess pool 8 Sewage lagoon 11 Fuel storage 15 Oil well/Gas well  
 3 Watertight sewer lines 6 Seepage pit 9 Feedyard 12 Fertilizer storage 16 Other (specify below)  
 13 Insecticide storage  
 Direction from well? Northwest How many feet? 30'

FROM	TO	LITHOLOGIC LOG	FROM	TO	PLUGGING INTERVALS
0	2	Surface			
2	16	Loess			
16	33	Sandy Clay w/Caliche Strks.			
33	56	Cemented Sand w/Clay Strks.			
56	80	Sandy Clay w/Caliche & Cemented Strks.			
80	100	Fine Sand w/Clay			
100	112	Sandy Clay w/Caliche & Some Sand			
112	116	Sandy Clay			
116	120	Sand, Caliche & Clay Mix			
120	145	Fine Sand w/Clay Strks.			
145	154	Cemented Sand			
154		Shale			

7 CONTRACTOR'S OR LANDOWNER'S CERTIFICATION: This water well was (1) constructed, (2) reconstructed, or (3) plugged under my jurisdiction and was completed on (mo/day/year) 7-1-94 and this record is true to the best of my knowledge and belief. Kansas Water Well Contractor's License No. 554 This Water Well Record was completed on (mo/day/yr) 7-5-94 under the business name of Woofter Pump & Well, Inc. by (signature) Jay Co. Woofter