

USE TYPEWRITER OR BALL POINT PEN-PRESS FIRMLY, PRINT CLEARLY.


WATER WELL RECORD KSA 82a-1201-1215

Kansas State Dept. Of Health (Water Well Contractors) Forbes-Bldg. 740 Topeka, Kansas 66620

CAS

1 Location of well:	County Decatur	Township name NW 1/4 of SW 4	Fraction I	Section number 4 S	Town number 26 W
---------------------	--------------------------	--	----------------------	------------------------------	----------------------------

Distance and direction from nearest town or city: 1 Mile Southwest Of Clayton, Kansas	3 Owner of well: Charles Griffith
Street address of well location if in city:	Address: Clayton Kansas

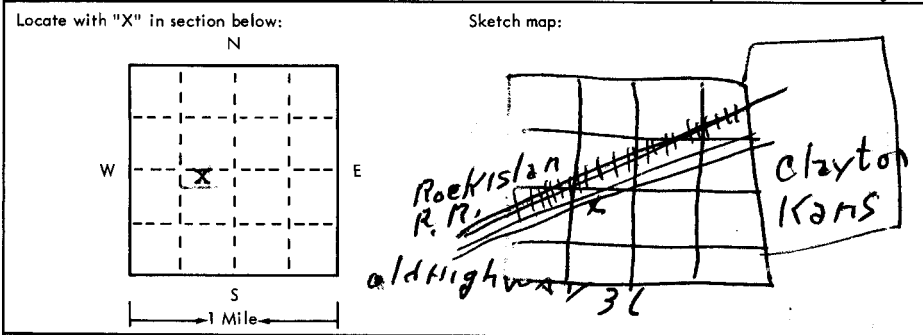

4 Well depth: <u>54</u> ft. Date of completion <u>7/20/75</u> Well diameter <u>9</u> in.
5 <input type="checkbox"/> Cable tool <input checked="" type="checkbox"/> Rotary <input type="checkbox"/> Driven <input type="checkbox"/> Dug <input type="checkbox"/> Hollow rod <input type="checkbox"/> Jetted <input type="checkbox"/> Bored <input type="checkbox"/> Reverse rotary
6 Use: <input checked="" type="checkbox"/> Domestic <input type="checkbox"/> Public supply <input type="checkbox"/> Industry <input type="checkbox"/> Irrigation <input type="checkbox"/> Air conditioning <input type="checkbox"/> Commercial <input type="checkbox"/> Test well
7 Casing: Material <u>RMP</u> Height: <u>above</u> below Threaded <input type="checkbox"/> Welded <input type="checkbox"/> Surface <u>12</u> in. Diam. <u>278</u> lbs./ft. <u>100</u> <u>5</u> in. to <u>44</u> ft. depth Drive shoe? <input type="checkbox"/> Yes <input checked="" type="checkbox"/> No <u> </u> in. to <u> </u> ft. depth

2 Type and color of material	From	To
Clay	0	36
Sand with blue clay	36	52
Blue shale	52	54

8 Screen: Manufacturer <u>Modern Pipe Inc.</u> Type <u>PVC</u> Dia. <u>5</u> Slot/gauze <u>Slot</u> Length <u>10'</u> Set between <u>44</u> ft. and <u>54</u> ft. Fittings: Gravel pack <input checked="" type="checkbox"/> Yes <input type="checkbox"/> No Size range of material <u>1/8"</u>
9 Static water level: <u>36</u> ft. below land surface Date <u>7/1/75</u>
10 Pumping level below land surfaces: <u>48</u> ft. after <u>1</u> hrs. pumping <u>18</u> g.p.m. <u> </u> ft. after <u> </u> hrs. pumping <u> </u> g.p.m. Estimated maximum yield <u>25</u> g.p.m.
11 Water sample submitted: <input type="checkbox"/> Yes <input checked="" type="checkbox"/> No Date <u> </u>
12 Well head completion: <input checked="" type="checkbox"/> Pitless adapter <u>12</u> inches above grade
13 Well grouted? <input checked="" type="checkbox"/> Yes <input type="checkbox"/> No <input checked="" type="checkbox"/> Neat cement <input type="checkbox"/> Bentonite Depth: From <u>4</u> ft. to <u>16</u> ft.
14 Nearest source of possible contamination: <u>Feed</u> ft. <u>150</u> Direction <u>South</u> Type <u>Lot</u> Well disinfected upon completion? <input checked="" type="checkbox"/> Yes <input type="checkbox"/> No
15 Pump: <u>Red Tanker</u> Manufacturer's name <u> </u> Model number <u>9BC</u> HP <u>3</u> Volts <u>230</u> Length of drop pipe <u>52</u> ft. capacity <u>9</u> g.m.p. Type: <input checked="" type="checkbox"/> Submersible <input type="checkbox"/> Turbine <input type="checkbox"/> Jet <input type="checkbox"/> Reciprocating <input type="checkbox"/> Centrifugal <input type="checkbox"/> Other

16 Remarks: elevation

2422 (top)

Topography:

Hill

Slope

Upland

Valley

17 Water well contractor's certification:
This well was drilled under my jurisdiction and this report is true to the best of my knowledge and belief.

John R. Fawcett & Son 167

Business name License No.
Address Box 149 Norton, Kansas

Signed John R. Fawcett Date 8/15/75
Authorized representative