

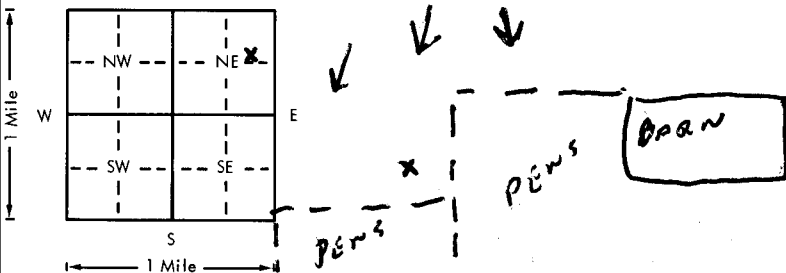
USE TYPEWRITER OR BALL
POINT PEN-PRESS FIRMLY,
PRINT CLEARLY.

CLAYTON

WATER WELL RECORD
KSA 82a-1201-1215

AAC

Kansas Department of Health and
Environment-Division of Environment
(Water well Contractors)
Topeka, Kansas 66620

1. Location of well:		County Decatur	Fraction SW 1/4 NE 1/4 NE 1/4	Section number 11	Township number T 4 S	Range number R 26
2. Distance and direction from nearest town or city: 2 miles southwest of Clayton KS Street address of well location if in city:				3. Owner of well: Rollie Harris R.R. or street: RR City, state, zip code: Clayton KS 67629		
4. Locate with "X" in section below:		Sketch map:		6. Bore hole dia. 9 in. Completion date 11-1-78 Well depth 59 ft.		
				7. ☒ Cable tool ☒ Rotary ☐ Driven ☐ Dug ☐ Hollow rod ☐ Jetted ☐ Bored ☐ Reverse rotary		
5. Type and color of material		From	To	8. Use: ☐ Domestic ☐ Public supply ☐ Industry ☐ Irrigation ☐ Air conditioning ☒ Stock ☐ Lawn ☐ Oil field water ☐ Other		
CLAY TAN		0	25	9. Casing: Material PLASTIC Height Above or below Threaded ☐ Welded ☐ Surface 18 in. RMP ☐ PVC ☒ Weight 325 lbs./ft. Dia. 5 in. to 49 ft. depth Wall Thickness: inches or Dia. ☐ in. to ☐ ft. depth gage No. 25P		
SAND (M)		25	58	10. Screen: Manufacturer's name MODERN PIPES INC Type PVC Dia. 5" Slot 0.30 Length 10' Set between 49 ft. and 59 ft. ft. and ☐ ft. Gravel pack? YES Size range of material 20-40		
SHALE BLUE		58	60	11. Static water level: ☐ mo./day/yr. 15 ft. below land surface Date 11-1-78		
BRICK 58'				12. Pumping level below land surfaces: ft. after ☐ hrs. pumping ☐ g.p.m. ft. after ☐ hrs. pumping ☐ g.p.m. Estimated maximum yield 25 g.p.m.		
				13. Water sample submitted: ☐ mo./day/yr. Yes ☒ No ☐ Date ☐		
				14. Well head completion: ☐ Pitless adapter 18 Inches above grade		
				15. Well grouted? YES With: ☐ Neat cement ☒ Bentonite ☐ Concrete Depth: From 0 ft. to 30 ft.		
				16. Nearest source of possible contamination: CATTLE ft. 50 Direction EAST Type PENS Well disinfected upon completion? ☒ Yes ☐ No		
				17. Pump: ☐ Not installed Manufacturer's name AERMOTOR Model number EDS-22 HP 1/2 Volts 220 Length of drop pipe 50 ft. capacity 5 g.p.m. Type: ☒ Submersible ☐ Turbine ☐ Jet ☐ Reciprocating ☐ Centrifugal ☐ Other		
18. Elevation:		(Use a second sheet if needed)		20. Water well contractor's certification: This well was drilled under my jurisdiction and this report is true to the best of my knowledge and belief. Edwett Drilling 167 Business name License No. Address Box 149 Norton KS. Signed Edwett Drilling Date 1-16-78 Authorized representative		
19. Remarks: 2431 (TOP)						

4 260 11 SW NE