

USE TYPEWRITER OR BALL POINT PEN-PRESS FIRMLY, PRINT CLEARLY.

T R EW sec 1/4 1/4 1/4 No.


WATER WELL RECORD
KSA 82a-1201-1215

Kansas State Dept. Of Health
(Water Well Contractors)
Forbes-Bldg. 740
Topeka, Kansas 66620

BDD

1 Location of well: County DECATUR Township name AVERTON Fraction SE SE 1/4 Section number 15 Town number H Range number X 26

Distance and direction from nearest town or city: HMC 5 W. Clayton, Kan
Street address of well location if in city: Clayton, Kan
3 Owner of well: MAC HARRIS
Address: Clayton, Kan

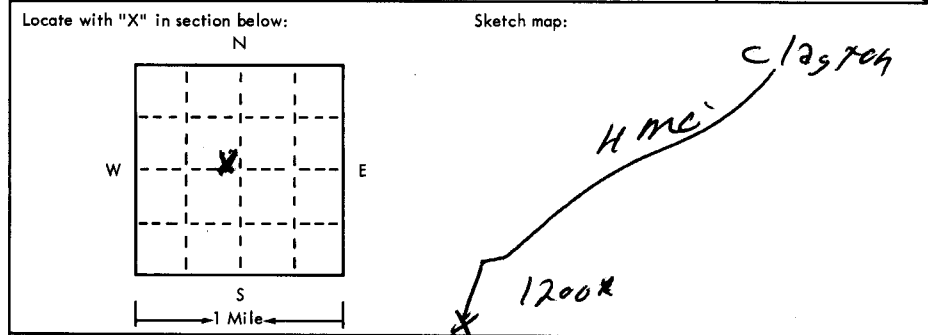

4 Well depth: 63 ft. Date of completion 9-12-76
Well diameter 28 in.
5 Cable tool Rotary Driven Dug
 Hollow rod Jetted Bored Reverse rotary
6 Use: Domestic Public supply Industry
 Irrigation Air conditioning Commercial
 Test well
7 Casing: Material CA Height: above/below
Threaded Welded Surface 6 in.
Diam. 16 in. to 63 ft. depth Drive shoe? Yes No
in. to ft. depth!

2	Type and color of material	From	To
	<u>BROWN CLG</u>	<u>0</u>	<u>36</u>
	<u>FINE TO MED. SAND</u>	<u>36</u>	<u>57</u>
	<u>GRAVEL WITH CLG STRUCKS</u>	<u>57</u>	<u>63</u>
	<u>SHALE</u>	<u>63</u>	
	<u>BROCK 63</u>		

8 Screen: Screen
Manufacturer JOHNSON MFG.
Type CA Dia. 2 1/2
Slot/gauze 3/16 Length 24
Set between 39 ft. and 63 ft.
Fittings: 41 TO 58
Gravel pack Yes No Size range of material

9 Static water level: 34 ft. below land surface Date 10 9-12-76

10 Pumping level below land surfaces:
62 ft. after 4 hrs. pumping 400 g.p.m.
ft. after hrs. pumping g.p.m.
Estimated maximum yield 400 g.p.m.

11 Water sample submitted: Yes No Date

12 Well head completion: Pitless adapter 6 inches above grade

13 Well grouted? Yes No
 Neat cement Bentonite
Depth: From 0 ft. to 10 ft.

14 Nearest source of possible contamination: FARM
ft. 3000 Direction N Type 9264
Well disinfected upon completion? Yes No

15 Pump: Not installed
Manufacturer's name
Model number HP Volts
Length of drop pipe ft. capacity g.m.p.
Type: Submersible Turbine
 Jet Reciprocating
 Centrifugal Other

16 Remarks: elevation

Topography:
 Hill
 Slope
 Upland
 Valley

17 Water well contractor's certification:
This well was drilled under my jurisdiction and this report is true to the best of my knowledge and belief.
Dick Drilling Co 303
Business name License No.
Address Hill City, Kan 663
Signed Dick Drilling Co Date 10-26-76
Authorized representative

4
26 W
15
SE 1/4