

USE TYPEWRITER OR BALL POINT PEN-PRESS FIRMLY, PRINT CLEARLY.

T R EW sec 1/4 1/4 1/4 No.

WATER WELL RECORD  
KSA 82a-1201-1215

Kansas State Dept. Of Health  
(Water Well Contractors)  
Forbes-Bldg. 740  
Topeka, Kansas 66620


BIBB

1 Location of well: County Decature Township name NW 1/4 of SW 1/4 of NW 1/4 of SE 1/4 of NW 1/4 Section number 15 Town number 4 S Range number 26 W


Distance and direction from nearest town or city:  
3 miles southwest of Jennings Kansas  
Street address of well location if in city:

3 Owner of well:  
Mac Harris  
Address: Clayton, Kansas

Locate with "X" in section below:

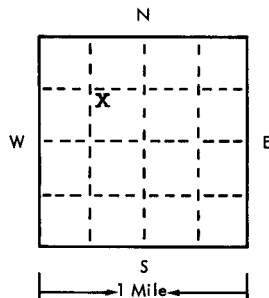

Sketch map:

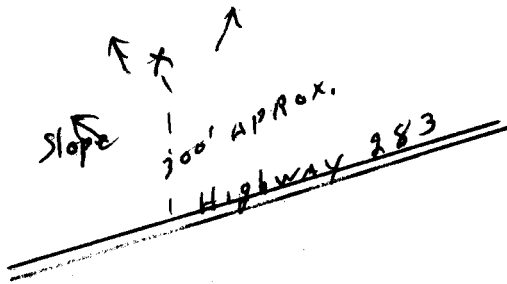

4 Well depth: 55 ft. Date of completion 10/9/75  
Well diameter 9 in.

5  Cable tool  Rotary  Driven  Dug  
 Hollow rod  Jetted  Bored  Reverse rotary

6 Use:  Domestic  Public supply  Industry  
 Irrigation  Air conditioning  Commercial  
 Test well  cattle feed lot

7 Casing: Material RMP Height: above/below  
Threaded  Welded  Surface 12 in.  
Diam. \_\_\_\_\_ Weight \_\_\_\_\_ lbs./ft. \_\_\_\_\_  
5 in. to 45 ft. depth Drive shoe?  Yes  No  
\_\_\_\_\_ in. to \_\_\_\_\_ ft. depth

2	Type and color of material	From	To
	Clay, yellow	0	40
	Sand, brown, v-f to coarse	40	50
	Shale, blue with oil	50	55
	<u>BIBB</u>		
	(use a second sheet if needed)		

8 Screen:  
Manufacturer Modern Pipes Inc.  
Type PVC Dia. 5  
Slot/gauze Slot Length 10  
Set between 45 ft. and 55 ft.  
Fittings: \_\_\_\_\_ 1-1/8  
Gravel pack  Yes  No Size range of material \_\_\_\_\_

9 Static water level:  
40 ft. below land surface Date 10/9/75

10 Pumping level below land surfaces:  
46 ft. after 1 hrs. pumping 16 g.p.m.  
\_\_\_\_\_ ft. after \_\_\_\_\_ hrs. pumping \_\_\_\_\_ g.p.m.  
Estimated maximum yield 22 g.p.m.

11 Water sample submitted:  
 Yes  No Date \_\_\_\_\_

12 Well head completion:  
 Pitless adapter 12  inches above grade

13 Well grouted?  Yes  No Wet clay  
 Neat cement  Bentonite   
Depth: From 4 ft. to 21 ft.

14 Nearest source of possible contamination: Dwelling  
1/4 mile Direction West Type \_\_\_\_\_  
Well disinfected upon completion?  Yes  No

15 Pump:  Not installed  
Manufacturer's name Aermotor Inc.  
Model number SD 5-33 HP 1/3 Volt 230  
Length of drop pipe 45 ft. capacity 5 g.m.p.  
Type:  
 Submersible  Turbine  
 Jet  Reciprocating  
 Centrifugal  Other

16 Remarks: elevation  
This well is for a proposed cattle feeding lot.  
2455 (TOPO)  
Topography:  
 Hill  
 Slope  
 Upland  
 Valley

17 Water well contractor's certification:  
This well was drilled under my jurisdiction and this report is true to the best of my knowledge and belief.  
John R. Fawcett & Son 167  
Business name \_\_\_\_\_ License No. \_\_\_\_\_  
Address Bx 149 Norton, Kansas  
Signed John R. Fawcett 10/20/75  
Authorized representative

4 26 W 15 NW SE NW