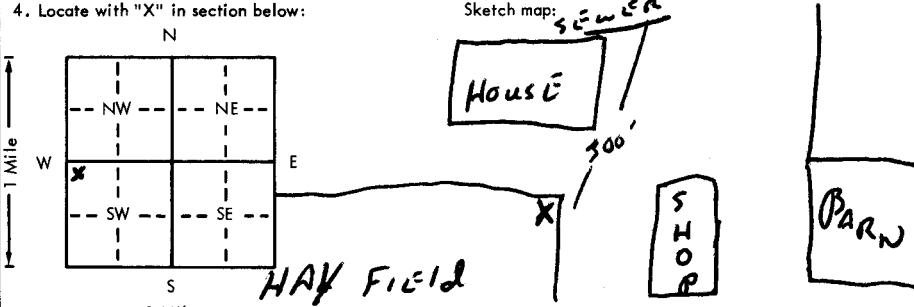


USE TYPEWRITER OR BALL POINT PEN-PRESS FIRMLY, PRINT CLEARLY.

WATER WELL RECORD  
KSA 82a-1201-1215

Kansas Department of Health and Environment-Division of Environment (Water well Contractors) Topeka, Kansas 66620

CBB

1. Location of well:	County <b>DECATUR</b>	Fraction <b>NW 1/4 NW 1/4 SW 1/4</b>	Section number <b>16</b>	Township number T <b>4</b> S	Range number R <b>26</b> E <b>(NW)</b>
2. Distance and direction from nearest town or city: <b>2 miles east of JENNINGS KS</b> Street address of well location if in city:			3. Owner of well: <b>Regis BENNETT</b> R.R. or street: City, state, zip code: <b>JENNINGS KS. 67643</b>		
4. Locate with "X" in section below: 			6. Bore hole dia. <b>9</b> in. Completion date _____ Well depth <b>44</b> ft.		
5. Type and color of material			7. <input checked="" type="checkbox"/> Cable tool <input checked="" type="checkbox"/> Rotary <input type="checkbox"/> Driven <input type="checkbox"/> Dug <input type="checkbox"/> Hollow rod <input type="checkbox"/> Jetted <input type="checkbox"/> Bored <input type="checkbox"/> Reverse rotary		
			8. Use: <input checked="" type="checkbox"/> Domestic <input type="checkbox"/> Public supply <input type="checkbox"/> Industry <input type="checkbox"/> Irrigation <input type="checkbox"/> Air conditioning <input type="checkbox"/> Stock <input type="checkbox"/> Lawn <input type="checkbox"/> Oil field water <input type="checkbox"/> Other		
			9. Casing: Material _____ Height: Above or below Threaded _____ Welded _____ Surface <b>12</b> in. RMP _____ PVC <input checked="" type="checkbox"/> Weight <b>275</b> lbs./ft. Dia. <b>5</b> in. to <b>24</b> ft. depth Wall Thickness: inches or Dia. _____ in. to _____ ft. depth gage No. <b>230</b>		
			10. Screen: Manufacturer's name <b>MODERN PIPES INC</b> Type <b>PVC</b> Dia. <b>5</b> Slot/gauze <b>032</b> Length <b>20</b> Set between <b>24</b> ft. and <b>44</b> ft. _____ ft. and _____ ft. Gravel pack? <input checked="" type="checkbox"/> YES Size range of material <b>1/2-1/4</b>		
			11. Static water level: _____ mo./day/yr. <b>18</b> ft. below land surface Date <b>11/1/76</b>		
			12. Pumping level below land surfaces: _____ ft. after _____ hrs. pumping _____ g.p.m. _____ ft. after _____ hrs. pumping _____ g.p.m. Estimated maximum yield <b>6-7</b> g.p.m.		
			13. Water sample submitted: _____ mo./day/yr. <input type="checkbox"/> Yes <input checked="" type="checkbox"/> No Date _____		
			14. Well head completion: <input checked="" type="checkbox"/> Pitless adapter <b>12</b> inches above grade		
			15. Well grouted? <input checked="" type="checkbox"/> YES With: <input type="checkbox"/> Neat cement <input type="checkbox"/> Bentonite <input checked="" type="checkbox"/> Concrete Depth: From <b>5</b> ft. to <b>15</b> ft.		
			16. Nearest source of possible contamination: ft. <b>360</b> Direction <b>NE</b> Type <b>SEWER</b> Well disinfected upon completion? <input checked="" type="checkbox"/> Yes <input type="checkbox"/> No		
			17. Pump: _____ Not installed Manufacturer's name <b>Aeromotor</b> Model number <b>SD 5</b> HP <b>1/2</b> Volts <b>230</b> Length of drop pipe <b>33</b> ft. capacity <b>5</b> g.p.m. Type: <input checked="" type="checkbox"/> Submersible <input type="checkbox"/> Turbine <input type="checkbox"/> Jet <input type="checkbox"/> Reciprocating <input type="checkbox"/> Centrifugal <input type="checkbox"/> Other		
18. Elevation:			19. Remarks:		
Topography: <input type="checkbox"/> Hill <input checked="" type="checkbox"/> Slope <input type="checkbox"/> Upland <input type="checkbox"/> Valley			<b>2462 (TOPO)</b>		
			20. Water well contractor's certification: This well was drilled under my jurisdiction and this report is true to the best of my knowledge and belief. <b>FRANKETTER SON DRILLING 167</b> Business name _____ License No. _____ Address <b>Box 149, Norton KS</b> Signed <b>[Signature]</b> Date <b>3/12/77</b> Authorized representative		

T 4 26 E 16 NW SW Sec 1/4 1/4 1/4