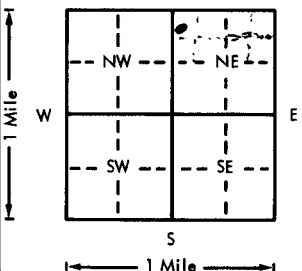


USE TYPEWRITER OR BALL POINT PEN-PRESS FIRMLY, PRINT CLEARLY.

WATER WELL RECORD
KSA 82a-1201-1215

Kansas Department of Health and Environment-Division of Environment
(Water well Contractors)
Topeka, Kansas 66620

ABB

1. Location of well:		County Decatur	Fraction NW¹/₄ NW¹/₄ NE¹/₄	Section number 14	Township number T 4 S	Range number R 27 W	
2. Distance and direction from nearest town or city: 2 N 1 1/2 W Street address of well location if in city: Jennings			3. Owner of well: Elmer Petracek R.R. or street: City, state, zip code: Jennings, Kans 67643				
4. Locate with "X" in section below: N W E S 1 Mile		Sketch map: 		6. Bore hole dia. 9 in. Completion date Well depth 101 ft. 9-25-76			
5. Type and color of material		From	To	7. <input type="checkbox"/> Cable tool <input checked="" type="checkbox"/> Rotary <input type="checkbox"/> Driven <input type="checkbox"/> Dug <input type="checkbox"/> Hollow rod <input type="checkbox"/> Jetted <input type="checkbox"/> Bored <input type="checkbox"/> Reverse rotary			
Topsoil		0	28	8. Use: <input type="checkbox"/> Domestic <input type="checkbox"/> Public supply <input type="checkbox"/> Industry <input type="checkbox"/> Irrigation <input type="checkbox"/> Air conditioning <input checked="" type="checkbox"/> Stock <input type="checkbox"/> Lawn <input type="checkbox"/> Oil field water <input type="checkbox"/> Other			
Clay		28	37	9. Casing: Material ABS Height: Above or below Threaded <input type="checkbox"/> Welded <input type="checkbox"/> Surface 12 in. RMP <input checked="" type="checkbox"/> PVC <input type="checkbox"/> Weight _____ lbs./ft. Dia. 5 in. to 91 ft. depth; Wall thickness: inches or Dia. _____ in. to _____ ft. depth; gage No. .250			
Sand (fine dark)		37	49	10. Screen: Manufacturer's name Sunflower Plastic Pipe Type RMP Dia. 5 in. Slot/gauze 1/16 Length 10 ft Set between 91 ft. and 101 ft. _____ ft. and _____ ft. Gravel pack? <input checked="" type="checkbox"/> Yes Size range of material 1/4 - 3/8			
Clay yellow		49	72	11. Static water level: _____ mo./day/yr. 78 ft. below land surface Date 9-14-76			
Sand fair		72	84	12. Pumping level below land surfaces: N, A, _____ ft. after _____ hrs. pumping _____ g.p.m. _____ ft. after _____ hrs. pumping _____ g.p.m. Estimated maximum yield _____ g.p.m.			
Sandy clay		84	86	13. Water sample submitted: _____ mo./day/yr. Yes <input checked="" type="checkbox"/> No <input type="checkbox"/> Date _____			
Sand medium		86	100	14. Well head completion: <input type="checkbox"/> Pitless adapter _____ inches above grade			
Shale yellow oker		100	101	15. Well grouted? <input checked="" type="checkbox"/> Yes With: <input type="checkbox"/> Neat cement <input checked="" type="checkbox"/> Bentonite <input type="checkbox"/> Concrete Depth: From 0 ft. to 14 ft.			
BROCK 100				16. Nearest source of possible contamination: ft. 300 Direction West Type Draw Well disinfected upon completion? _____ Yes <input checked="" type="checkbox"/> No <input type="checkbox"/>			
				17. Pump: <input checked="" type="checkbox"/> Not installed Manufacturer's name _____ HP _____ Volts _____ Model number _____ Length of drop pipe _____ ft. capacity _____ g.p.m. Type: <input type="checkbox"/> Submersible <input type="checkbox"/> Turbine <input type="checkbox"/> Jet <input type="checkbox"/> Reciprocating <input type="checkbox"/> Centrifugal <input type="checkbox"/> Other			
				18. Elevation:			
				19. Remarks: Topography: <input checked="" type="checkbox"/> Hill <input type="checkbox"/> Slope <input type="checkbox"/> Upland <input type="checkbox"/> Valley			
				20. Water well contractor's certification: This well was drilled under my jurisdiction and this report is true to the best of my knowledge and belief. Selden Drilling 339 Business name License No. Address Selden, KS Signed B.T. Wagner Date 10-18-76 Authorized representative			

T
F
27
W
E
14
F
1/4
1/4
1/4
1/4