

WATER WELL PLUGGING RECORD Form WWC-5P

KSA 82a-1212 ID NO.

1 LOCATION OF WATER WELL: County: Decatur	Fraction SW 1/4 SW 1/4 SW 1/4	Section Number 33	Township Number 4	Range Number 27 E
---	---	-----------------------------	-----------------------------	-----------------------------

Distance and direction from nearest town or city street address of well if located within city?

3 1/2 miles NE of Dresden

2 WATER WELL OWNER:

Arlene Sanns
RR#, St. Address, Box #:
15040 Red Rock Rd.
City, State ZIP Code:
Reno, Nevada 89506-9530

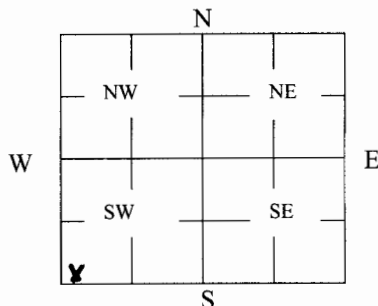
Global Positioning Systems (decimal degrees, min. of 4 digits)

Latitude: **39.65501**Longitude: **100.36628**Elevation: **2602**

Datum:

Data Collection Method:

3 MARK WELL'S LOCATION WITH AN "X" IN SECTION BOX:

4 DEPTH OF WELL **est. 100' ±** ft. - **Plugged by collapsed casing @ 14'**WELL'S STATIC WATER LEVEL **est. 100' ±** ft "

WELL WAS USED AS:

☒ Domestic

2 Irrigation

3 Feedlot

4 Industrial

5 Public Water Supply

6 Oil Field Water Supply

7 Domestic (Lawn & Garden)

8 Air Conditioning

9 Dewatering

10 Monitoring

11 Injection Well

12 Other

Was a chemical/bacteriological sample submitted to Department? Yes No ☒ X

5 TYPE OF BLANK CASING USED:

☒ Steel

3 RMP (SR)

5 Wrought

7 Fiberglass

9 Other (Specify below)

2 PVC

4 ABS

6 Asbestos-Cement

8 Concrete Tile

Blank casing diameter **5** in. Was casing pulled? Yes ☒ X No If yes, how much **3' +**
Casing height above or below and surface **-36'** in.

6 GROUT PLUG MATERIAL:

1 Neat cement

2 Cement grout

☒ 3 Bentonite

4 Other

Grout Plug Intervals: From **-6** ft. to **-3** ft., From _____ ft. to _____ ft., From _____ to _____ ft.

What is the nearest source of possible contamination:

1 Septic tank

6 Seepage pit

11 Fuel Storage

16 Other (specify below)

2 Sewer lines

7 Pit privy

12 Fertilizer storage

3 Watertight sewer lines

8 Sewage lagoon

13 Insecticide storage

4 Lateral lines

9 Feedyard

☒ 14 Abandoned water wellDirection from well? **N**

5 Cess pool

10 Livestock pens

15 Oil well/Gas well

How many feet? **12'**

FROM	TO	PLUGGING MATERIALS	FROM	TO	PLUGGING MATERIALS
-100'	-14'	5 gal. 4-1 Water to Chlorox mixture & some sand until bridged at -14'			
-14'	-6'	clayey native material			where casing was collapsed
-6'	-3'	Bentonite			
-3'	Surface	Top Soil			
*Most of pipe and cylinder had to be left in the well. Pipe was cut off at ~ -4'					

7 CONTRACTOR'S OR LANDOWNER'S CERTIFICATION: This water well was plugged under my jurisdiction and was completed on (mo/day/year) **6-12-09** and this record is true to the best of my knowledge and belief. Kansas Water Well Contractor's License No. **398398**. This Water Well Record was completed on (mo/day/year) **6-15-09** under the business name **Kelly Drilling Co** by (signature) **Richard O. Kelly**

INSTRUCTIONS: Use typewriter or ballpoint pen. Please press firmly and print clearly. Please fill in blanks, underline or circle the correct answers. Send top three copies to Kansas Department of Health and Environment, Bureau of Water, Geology Section, 1000 SW Jackson St., Ste. 420, Topeka, Kansas 66612-1367. Telephone: 785/296-5522. Send one to Water Well Owner and retain one for your records. Visit us at <http://www.kdheks.gov/geo/waterwells>.