WATER WELL PLUGGING RECORD Form WWC-5P KSA 82a-1212 ID NO.

1 LOCATION OF WATER WELL: County: Decatur	Fraction: SW ¼ SW ¼ SW ¼	Section Number: 33	Township Number: 4	Range Number: 27 E/W

Distance and direction from nearest town or city street address of well if located within city?
3½ miles NE of Dresden

2 WATER WELL OWNER: Arlene Sanns
RR#, St. Address, Box #: 15040 Red Rock Rd.
City, State ZIP Code: Reno, Nevada 89506-9530

Global Positioning Systems (decimal degrees, min. of 4 digits
Latitude: 39.65504
Longitude: 100.366028
Elevation: 2602
Datum:
Data Collection Method:

3 MARK WELL'S LOCATION WITH AN "X" IN SECTION BOX:

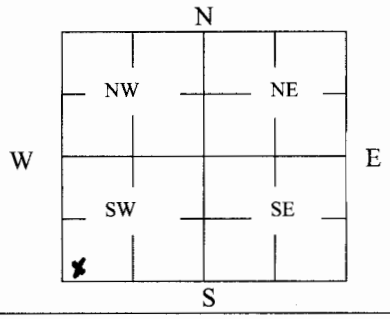

4 DEPTH OF WELL 100 ft.
WELL'S STATIC WATER LEVEL Wet @ 100 ft

WELL WAS USED AS:

(1) Domestic	5 Public Water Supply	9 Dewatering
2 Irrigation	6 Oil Field Water Supply	10 Monitoring
3 Feedlot	7 Domestic (Lawn & Garden)	11 Injection Well
4 Industrial	8 Air Conditioning	12 Other

Was a chemical/bacteriological sample submitted to Department? Yes ____ No X

5 TYPE OF BLANK CASING USED:

(1) Steel	3 RMP (SR)	5 Wrought	7 Fiberglass	9 Other (Specify below)
2 PVC	4 ABS	6 Asbestos-Cement	8 Concrete Tile	

Blank casing diameter 5 in. Was casing pulled? Yes X No ____ If yes, how much 3'4
Casing height above or (below) land surface ~36+ in.

6 GROUT PLUG MATERIAL: 1 Neat cement 2 Cement grout (3) Bentonite 4 Other ____

Grout Plug Intervals: From -98 ft. to -93 ft., From -13 ft. to -3 ft., From ____ to ____ ft.

What is the nearest source of possible contamination:

1 Septic tank	6 Seepage pit	11 Fuel Storage	16 Other (specify below)
2 Sewer lines	7 Pit privy	12 Fertilizer storage	
3 Watertight sewer lines	8 Sewage lagoon	13 Insecticide storage	
4 Lateral lines	9 Feedyard	(14) Abandoned water well	Direction from well? 5,
5 Cess pool	10 Livestock pens	15 Oil well/Gas well	How many feet? 12

FROM	TO	PLUGGING MATERIALS	FROM	TO	PLUGGING MATERIALS
-100'	-98'	5gal 4-1 Water to Chlorox mixture then 2' sand			
-98'	-93'	Bentonite			
-93'	-13'	Clayey native material			
-13'	-3	Bentonite			
-3'	Surface	Top Soil			

7 CONTRACTOR'S OR LANDOWNER'S CERTIFICATION: This water well was plugged under my jurisdiction and was completed on (mo/day/year) 6-12-09 and this record is true to the best of my knowledge and belief. Kansas Water Well Contractor's License No. 398. This Water Well Record was completed on (mo/day/year) 6-15-09 under the business name of Kelley Drilling Co. by (signature) Richard O. Kelley.

INSTRUCTIONS: Use typewriter or ballpoint pen. Please press firmly and print clearly. Please fill in blanks, underline or circle the correct answers. Send top three copies to Kansas Department of Health and Environment, Bureau of Water, Geology Section, 1000 SW Jackson St., Ste. 420, Topeka, Kansas 66612-1367. Telephone: 785/296-5522. Send one to Water Well Owner and retain one for your records. Visit us at http://www.kdheks.gov/geo/waterwells.