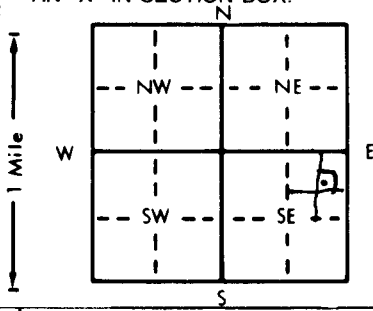


WATER WELL RECORD Form WWC-5 KSA 82a-1212

1 LOCATION OF WATER WELL:		Fraction <u>NE</u> <u>SE</u>	Section Number <u>9</u>	Township Number <u>T 4 S</u>	Range Number <u>R 29 E/W</u>
County: <u>Decatur</u>					
Distance and direction from nearest town or city street address of well if located within city? <u>8 Mi south and 2 1/2 mi west for Oberlin, Kansas</u>					
2 WATER WELL OWNER: RR#, St. Address, Box # : <u>Circle W. Inc.</u> <u>Rt. Box 77</u> City, State, ZIP Code : <u>Oberlin Kansas 67749</u> Board of Agriculture, Division of Water Resources Application Number:					
3 LOCATE WELL'S LOCATION WITH AN "X" IN SECTION BOX:		4 DEPTH OF COMPLETED WELL <u>102</u> ft. ELEVATION:			
		Depth(s) Groundwater Encountered 1. <u>36</u> ft. 2. ft. 3. ft.			
		WELL'S STATIC WATER LEVEL <u>36</u> ft. below land surface measured on mo/day/yr			
		Pump test data: Well water was ft. after hours pumping gpm			
		Est. Yield <u>10</u> gpm: Well water was ft. after hours pumping gpm			
Bore Hole Diameter <u>8</u> in. to ft., and in. to ft.		WELL WATER TO BE USED AS:			
1 Domestic		3 Feedlot	6 Oil field water supply	9 Dewatering	12 Other (Specify below)
2 Irrigation		4 Industrial	7 Lawn and garden only	10 Monitoring well	
Was a chemical/bacteriological sample submitted to Department? Yes No <u>X</u> ; If yes, mo/day/yr sample was submitted					
Water Well Disinfected? Yes <u>X</u> No					
5 TYPE OF BLANK CASING USED:					
1 Steel		3 RMP (SR)	5 Wrought iron	8 Concrete tile	CASING JOINTS: Glued <u>X</u> Clamped
2 PVC		4 ABS	6 Asbestos-Cement	9 Other (specify below)	Welded
Blank casing diameter <u>5</u> in. to <u>82</u> ft., Dia.		7 Fiberglass			Threaded
Casing height above land surface <u>12</u> in., weight lbs./ft. Wall thickness or gauge No. <u>258</u>					
TYPE OF SCREEN OR PERFORATION MATERIAL:					
1 Steel		3 Stainless steel	5 Fiberglass	8 RMP (SR)	10 Asbestos-cement
2 Brass		4 Galvanized steel	6 Concrete tile	9 ABS	11 Other (specify)
SCREEN OR PERFORATION OPENINGS ARE:		5 Gauzed wrapped	8 Saw cut	11 None (open hole)	
1 Continuous slot		3 Mill slot	6 Wire wrapped	9 Drilled holes	
2 Louvered shutter		4 Key punched	7 Torch cut	10 Other (specify)	
SCREEN-PERFORATED INTERVALS: From <u>102</u> ft. to <u>82</u> ft., From ft. to ft.					
GRAVEL PACK INTERVALS: From <u>102</u> ft. to <u>25</u> ft., From ft. to ft.					
6 GROUT MATERIAL: 1 Neat cement 2 <u>Cement grout</u> 3 Bentonite 4 Other					
Grout Intervals: From <u>25</u> ft. to <u>5</u> ft., From ft. to ft., From ft. to ft.					
What is the nearest source of possible contamination:					
1 Septic tank		4 Lateral lines	7 Pit privy	10 Livestock pens	14 Abandoned water well
2 Sewer lines		5 Cess pool	8 Sewage lagoon	11 Fuel storage	15 Oil well/Gas well
3 Watertight sewer lines		6 Seepage pit	9 Feedyard	12 Fertilizer storage	16 Other (specify below)
				13 Insecticide storage	<u>none</u>
Direction from well? How many feet?					
FROM	TO	LITHOLOGIC LOG	FROM	TO	PLUGGING INTERVALS
0	16	Top			
16	57	limstone			
57	61	fine sand			
61	69	clay			
69	76	sand			
76	78	clay			
78	102	tight sand			
102		shale			
7 CONTRACTOR'S OR LANDOWNER'S CERTIFICATION: This water well was (1) <u>constructed</u> , (2) reconstructed, or (3) plugged under my jurisdiction and was completed on (mo/day/year) <u>8-30-94</u> and this record is true to the best of my knowledge and belief. Kansas					
Water Well Contractor's License No. <u>398</u> This Water Well Record was completed on (mo/day/yr) <u>9-15-94</u>					
under the business name of <u>Kelley Drilling Co.</u> by (signature) <u>Richard B. Kelley</u>					
INSTRUCTIONS: Use typewriter or ball point pen. PLEASE PRESS FIRMLY and PRINT clearly. Please fill in blanks, underline or circle the correct answers. Send top three copies to Kansas Department of Health and Environment, Bureau of Water, Topeka, Kansas 66620-0001. Telephone: 913-296-5545. Send one to WATER WELL OWNER and retain one for your records.					