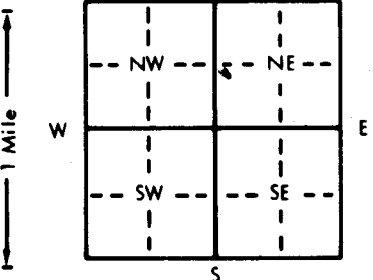


1 LOCATION OF WATER WELL: County: Decatur		Fraction Nw 1/4 Sw 1/4 NE 1/4		Section Number 9	Township Number T 4 S	Range Number R 29 E/W
Distance and direction from nearest town or city street address of well if located within city? 7 mi south and 3 mi west of Oberlin, Kansas						
2 WATER WELL OWNER: RR#, St. Address, Box #: John Brown Rt. 1 Box 77 City, State, ZIP Code: Oberlin, Kansas 67749 Board of Agriculture, Division of Water Resources Application Number:						
3 LOCATE WELL'S LOCATION WITH AN "X" IN SECTION BOX:		4 DEPTH OF COMPLETED WELL plugged 22 ft. ELEVATION:				
		Depth(s) Groundwater Encountered 1. 19 ft. 2. ft. 3. ft.				
		WELL'S STATIC WATER LEVEL 19 ft. below land surface measured on mo/day/yr				
		Pump test data: Well water was ft. after hours pumping gpm				
		Est. Yield gpm: Well water was ft. after hours pumping gpm				
Bore Hole Diameter. in. to ft., and in. to ft.		WELL WATER TO BE USED AS:				
		5 Public water supply 8 Air conditioning 11 Injection well				
		1 Domestic 3 Feedlot 6 Oil field water supply 9 Dewatering 12 Other (Specify below)				
		2 Irrigation 4 Industrial 7 Lawn and garden only 10 Monitoring well				
		Was a chemical/bacteriological sample submitted to Department? Yes No; If yes, mo/day/yr sample was submitted				
		Water Well Disinfected? Yes X No				
5 TYPE OF BLANK CASING USED:						
1 Steel 3 RMP (SR) 5 Wrought iron 8 Concrete tile CASING JOINTS: Glued Clamped						
2 PVC 4 ABS 6 Asbestos-Cement 9 Other (specify below) Welded						
Blank casing diameter 4 in. to ft., Dia. in. to ft., Dia. in. to ft.						
Casing height above land surface 48 in., weight lbs./ft. Wall thickness or gauge No.						
TYPE OF SCREEN OR PERFORATION MATERIAL:						
1 Steel 3 Stainless steel 5 Fiberglass 7 PVC 10 Asbestos-cement						
2 Brass 4 Galvanized steel 6 Concrete tile 8 RMP (SR) 11 Other (specify) NA						
12 None used (open hole)						
SCREEN OR PERFORATION OPENINGS ARE:						
1 Continuous slot 3 Mill slot 5 Gauzed wrapped 8 Saw cut 11 None (open hole)						
2 Louvered shutter 4 Key punched 6 Wire wrapped 9 Drilled holes						
7 Torch cut 10 Other (specify) NA						
SCREEN-PERFORATED INTERVALS: From NA ft. to NA ft., From ft. to ft.						
GRAVEL PACK INTERVALS: From ft. to ft., From ft. to ft.						
From ft. to ft., From ft. to ft.						
6 GROUT MATERIAL: 1 Neat cement 2 <u>Cement grout</u> 3 Bentonite 4 Other						
Grout Intervals: From 6 ft. to 0 ft., From ft. to ft., From ft. to ft.						
What is the nearest source of possible contamination:						
1 Septic tank 4 Lateral lines 7 Pit privy 10 Livestock pens 14 Abandoned water well						
2 Sewer lines 5 Cess pool 8 Sewage lagoon 11 Fuel storage 15 Oil well/Gas well						
3 Watertight sewer lines 6 Seepage pit 9 Feedyard 12 Fertilizer storage 16 Other (specify below)						
13 Insecticide storage						
Direction from well? How many feet?						
FROM	TO	LITHOLOGIC LOG	FROM	TO	PLUGGING INTERVALS	
			22	19	chlorinated sand	
			19	6	clay dirt	
			6	0	cement grout	
7 CONTRACTOR'S OR LANDOWNER'S CERTIFICATION: This water well was (1) constructed, (2) reconstructed, or (3) <u>plugged</u> under my jurisdiction and was completed on (mo/day/year) 3-17-95 and this record is true to the best of my knowledge and belief. Kansas Water Well Contractor's License No. 398 This Water Well Record was completed on (mo/day/yr) 4-8-95 under the business name of Kelley D rilling Co. by (signature) <i>Richard D. Kelley</i>						
INSTRUCTIONS: Use typewriter or ball point pen. PLEASE PRESS FIRMLY and PRINT clearly. Please fill in blanks, underline or circle the correct answers. Send top three copies to Kansas Department of Health and Environment, Bureau of Water, Topeka, Kansas 66620-0001. Telephone: 913-296-5545. Send one to WATER WELL OWNER and retain one for your records.						