


1 LOCATION OF WATER WELL: County: Republic	Fraction NE 1/4 SE 1/4 SE 1/4	Section Number 23	Township Number T 4 S	Range Number R 3 E/W
-----------------------------------------------	----------------------------------	----------------------	--------------------------	-------------------------

Distance and direction from nearest town or city street address of well if located within city?
Approximately 1 1/2 miles west and 3/4 mile south of Talmo

2 WATER WELL OWNER: Eldon Trost
RR#, St. Address, Box #: Route 2
City, State, ZIP Code: Belleville, KS 66935
Board of Agriculture, Division of Water Resources
Application Number: 41,606

3 LOCATE WELL'S LOCATION WITH AN "X" IN SECTION BOX:

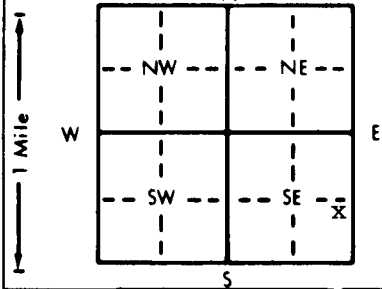

4 DEPTH OF COMPLETED WELL: 86 ft. ELEVATION: unknown
Depth(s) Groundwater Encountered 1. ft. 2. ft. 3. ft.
WELL'S STATIC WATER LEVEL: 26 ft. below land surface measured on mo/day/yr 6-12-96
Pump test data: Well water was not ch'd ft. after hours pumping gpm
Est. Yield unknown gpm: Well water was ft. after hours pumping gpm
Bore Hole Diameter: 24 in. to 85 ft., and in. to ft.
WELL WATER TO BE USED AS:
5 Public water supply 8 Air conditioning 11 Injection well
1 Domestic 3 Feedlot 6 Oil field water supply 9 Dewatering 12 Other (Specify below)
2 Irrigation 4 Industrial 7 Lawn and garden only 10 Monitoring well
Was a chemical/bacteriological sample submitted to Department? Yes No ; If yes, mo/day/yr sample was submitted
Water Well Disinfected? Yes No

5 TYPE OF BLANK CASING USED:
1 Steel 3 RMP (SR) 5 Wrought iron 8 Concrete tile CASING JOINTS: Glued Clamped
2 PVC 4 ABS 6 Asbestos-Cement 9 Other (specify below) Welded
7 Fiberglass Threaded
Blank casing diameter: 16 in. to 38 ft., Dia in. to ft., Dia in. to ft.
Casing height above land surface: 12 in., weight 16.50 lbs./ft. Wall thickness or gauge No. 500

TYPE OF SCREEN OR PERFORATION MATERIAL:
1 Steel 3 Stainless steel 5 Fiberglass 7 PVC 10 Asbestos-cement
2 Brass 4 Galvanized steel 6 Concrete tile 8 RMP (SR) 11 Other (specify)
9 ABS 12 None used (open hole)

SCREEN OR PERFORATION OPENINGS ARE:
1 Continuous slot 3 Mill slot 5 Gauzed wrapped 8 Saw cut 11 None (open hole)
2 Louvered shutter 4 Key punched 6 Wire wrapped 9 Drilled holes
7 Torch cut 10 Other (specify)

SCREEN-PERFORATED INTERVALS: From 38 ft. to 85 ft., From ft. to ft.
GRAVEL PACK INTERVALS: From 30 ft. to 85 ft., From ft. to ft.

6 GROUT MATERIAL: 1 Neat cement 2 Cement grout 3 Bentonite 4 Other Bentonite Holeplug
Grout Intervals: From 0 ft. to 28 ft., From ft. to ft., From 28 ft. to 30 ft.

What is the nearest source of possible contamination:
1 Septic tank 4 Lateral lines 7 Pit privy 10 Livestock pens 14 Abandoned water well
2 Sewer lines 5 Cess pool 8 Sewage lagoon 11 Fuel storage 15 Oil well/Gas well
3 Watertight sewer lines 6 Seepage pit 9 Feedyard 12 Fertilizer storage 16 Other (specify below)
13 Insecticide storage None known

Direction from well? How many feet?

FROM	TO	LITHOLOGIC LOG	FROM	TO	EXPLANATION OF DEVIATIONS
0	2	Topsoil	84	85	Clay
2	14	Clay, brown			
14	17	Clay, reddish-brown			
17	34	Clay, brown			
34	38	Limestone gravel			
38	38.5	Clay streak			
38.5	41	Limestone gravel, fine with clay			
41	46	Clay			
46	51	Sand and gravel, fine with clay			
51	54	Clay with fine sand			
54	56	Clay			
56	59	Limestone gravel			
59	65	Clay			
65	78	Clay, black			
78	84	Limestone gravel, medium, coarse			

7 CONTRACTOR'S OR LANDOWNER'S CERTIFICATION: This water well was (1) constructed, (2) reconstructed, or (3) plugged under my jurisdiction and was completed on (mo/day/year) 6-12-96 and this record is true to the best of my knowledge and belief. Kansas Water Well Contractor's License No. 185 This Water Well Record was completed on (mo/day/yr) 7-3-96 under the business name of Clarke Well & Equipment, Inc. by (signature) *Clarke Well & Equipment*