


1 LOCATION OF WATER WELL: Fraction Section Number Township Number Range Number
 County: Republic SW 1/4 SE 1/4 23 4 3 E/W

Distance and direction from nearest town or city street address of well if located within city?
K148 + 180 Rd; 1 mile S; 1/2 E on Xavier Rd; N side of the Road

2 WATER WELL OWNER: Phyllis Sherwood
2436 F St.
 RR #, St. Address, Box #: Belleville, KS 66935
 City, State, ZIP Code : Board of Agriculture, Division of Water Resources
 Application Number:

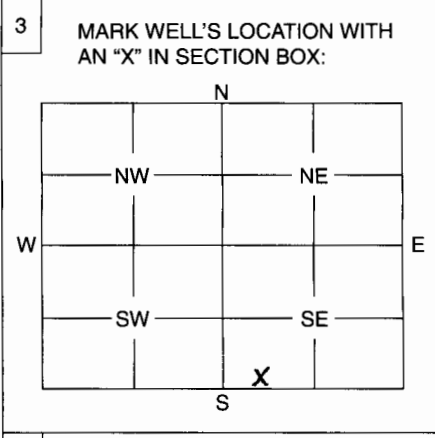

4 DEPTH OF WELL 45.5 ft.
 WELL'S STATIC WATER LEVEL 38.5 ft.
 WELL WAS USED AS:
 1 Domestic 5 Public Water Supply 9 Dewatering
 2 Irrigation 6 Oil Field Water Supply 10 Monitoring Well
 3 Feedlot 7 Domestic (Lawn & Garden) 11 Injection Well
 4 Industrial 8 Air Conditioning 12 Other Livestock
 Was a chemical / bacteriological sample submitted to Department? Yes No
 If yes, mo/day/yr sample was submitted
 Water Well Disinfected: Yes No

5 TYPE OF BLANK CASING USED:
 1 Steel 3 RMP (SR) 5 Wrought 7 Fiberglass 9 Other (Specify below) Limestone
 2 PVC 4 ABS 6 Asbestos-Cement 8 Concrete Tile
 Blank casing diameter 54 in. Was casing pulled? Yes No If yes, how much 4 1/2 - 5'
 Casing height above or below land surface 60 in.

6 GROUT PLUG MATERIAL: 1 Neat cement 2 Cement grout 3 Bentonite 4 Other
 Grout Plug Intervals: From 4 1/2 ft. to 5 ft., From ft. to ft., From to ft.
 What is the nearest source of possible contamination:
 1 Septic tank 6 Seepage pit 11 Fuel storage 16 Other (specify below)
 2 Sewer lines 7 Pit privy 12 Fertilizer storage
 3 Watertight sewer lines 8 Sewage lagoon 13 Insecticide storage
 4 Lateral lines 9 Feedyard 14 Abandoned water well
 5 Cess pool 10 Livestock pens 15 Oil well/Gas well
 Direction from well? In Cropland How many feet? Surrounding

FROM	TO	PLUGGING MATERIALS
<u>0</u>	<u>4 1/2</u>	<u>Topsoil</u>
<u>4 1/2</u>	<u>5</u>	<u>Bentonite Plug</u>
<u>5</u>	<u>38.5</u>	<u>Subsoil</u>
<u>38.5</u>	<u>45.5</u>	<u>Gravel</u>

7 CONTRACTOR'S OF LANDOWNER'S CERTIFICATION: This water well was plugged under my jurisdiction and was completed on (mo/day/year) 12/21/06 and this record is true to the best of my knowledge and belief. Kansas Water Well Contractor's License No. 11715106 This Water Well Record was completed on (mo/day/year) 12/21/06 under the business name of by (signature) [Signature]

INSTRUCTIONS: Use typewriter or ball point pen. Please press firmly and print clearly. Please fill in blanks, underline or circle the correct answers. Send top three copies to Kansas Department of Health and Environment, Bureau of Water, Geology Section, 1000 SW Jackson St., Ste. 420, Topeka, Kansas 66612-1367. Telephone: 785/296-5522. Send one to Water Well Owner and retain one for your records.