


USE TYPEWRITER OR BALL POINT PEN - PRESS FIRMLY - PRINT CLEARLY.

WATER WELL RECORD
KSA 82a-1201-1215


Kansas Department of Health and Environment - Division of Environment
(Water well Contractors)
Topeka, Kansas 66620

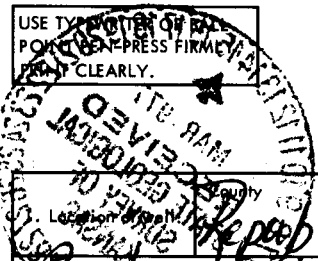

County: Republic Fraction: 1/4 1/4 1/4 Section number: 16 Township number: 4 Range number: 3 E/W

2. Distance and direction from nearest town or city:
3 miles North of Concordia 1/2 east
1/4 north west side of road

3. Owner of well: Jett Seardoe
R.R. or street: Rt 6
City, state, zip code: Concordia Kansas 66901

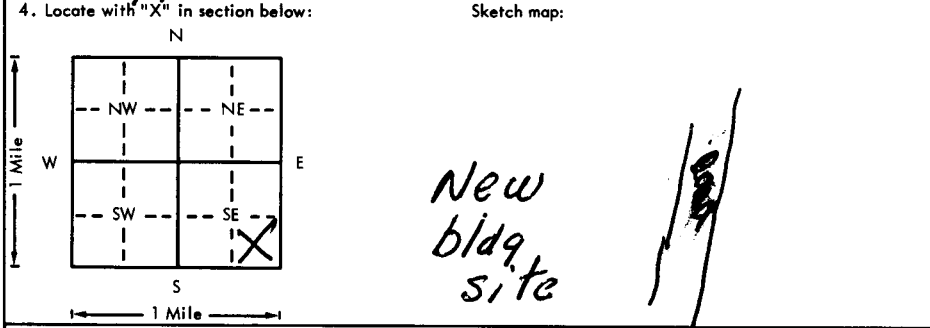

6. Bore hole dia. 8 in. Completion date: Nov. 17, 1976
Well depth: 45 ft.
7. Cable tool Rotary Driven Dug
 Hollow rod Jetted Bored Reverse rotary
8. Use: Domestic Public supply Industry
 Irrigation Air conditioning Stock
 Lawn Oil field water Other
9. Casing: Material _____ Height: Above or below
Threaded _____ Welded _____ Surface 24 in.
RMP _____ PVC Weight _____ lbs./ft.
Dia. 5 in. to 45 ft. depth Wall Thickness _____ inches or
Dia. _____ in. to _____ ft. depth gage No. 14

5. Type and color of material	From	To
<u>Black soil</u>	<u>0</u>	<u>19</u>
<u>fine sand</u>	<u>20</u>	<u>24</u>
<u>Gravel</u>	<u>25</u>	<u>42</u>
<u>CLAY</u>	<u>43</u>	

10. Screen: Manufacturer's name: CAN-TEX
Type: 100/1 Dia. 5"
Slot/gauze: 1/64 Length: 10'
Set between: 35 ft. and 45 ft.
_____ ft. and _____ ft.
Gravel pack? Size range of material: 1/4
11. Static water level: _____ ft. below land surface Date: 11/18/76
12. Pumping level below land surfaces:
35 ft. after 1 hrs. pumping 8 g.p.m.
_____ ft. after _____ hrs. pumping _____ g.p.m.
Estimated maximum yield: 10 g.p.m.
13. Water sample submitted: _____ no./day/yr.
 Yes No Date: 11/30/76
14. Well head completion: AD Pitless adapter 24 inches above grade
15. Well grouted?
With: Neat cement Bentonite Concrete
Depth: From 1 ft. to 10 ft.
16. Nearest source of possible contamination:
ft. 300 Direction: South Type: Creek
Well disinfected upon completion? Yes No
17. Pump: Not installed
Manufacturer's name _____
Model number _____ HP _____ Volts _____
Length of drop pipe _____ ft. capacity _____ g.p.m.
Type:
 Submersible Turbine
 Jet Reciprocating
 Centrifugal Other

18. Elevation: 1405
Topography:
 Hill
 Slope
 Upland
 Valley
19. Remarks:

20. Water well contractor's certification:
This well was drilled under my jurisdiction and this report is true to the best of my knowledge and belief. 247
Business name: Carl Thomen son License No. _____
Address: 303 E 16th St Concordia KS
Signed: Carl Thomen son Date: 12/20/76
Authorized Representative

T-4-30-16-SE-SE
R
1/4 1/4 1/4