


1	LOCATION OF WATER WELL:	Fraction	Section Number	Township Number	Range Number
	County: Decatur	SE ¼ NW ¼ NE ¼	1	T 4 S	R 30 E/W

7 mi south and 7½ mi. west of Oberlin, Kansas

3 LOCATE WELL'S LOCATION WITH AN "X" IN SECTION BOX: 4 DEPTH OF COMPLETED WELL... 63 ft. ELEVATION:

4 DEPTH OF COMPLETED WELL... 63 ft. ELEVATION:

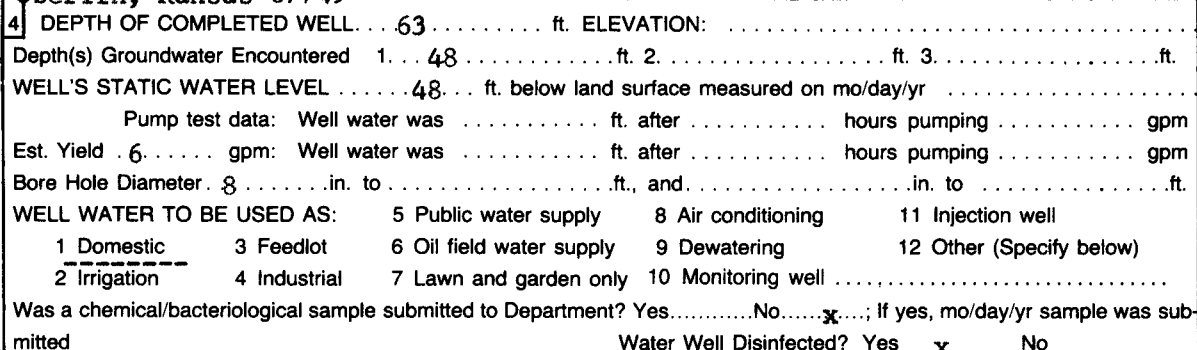

Blank casing diameter . . . 5 in. to 53 ft., Dia in. to ft., Dia in. to ft.
Casing height above land surface . . . 12 in., weight lbs./ft. Wall thickness or gauge No. . . 258.

SCREEN OR PERFORATION OPENINGS ARE:		5 Gauzed wrapped	8 Saw cut	11 None (open hole)
1 Continuous slot	3 Mill slot	6 Wire wrapped	<u>9 Drilled holes</u>	
2 Louvered shutter	4 Key punched	7 Torch cut	10 Other (specify)	

SCREEN-PERFORATED INTERVALS:	From 63 ft. to 53 ft.,	From ft. to ft.
	From ft. to ft.,	From ft. to ft.
GRAVEL PACK INTERVALS:	From 63 ft. to 25 ft.,	From ft. to ft.
	From ft. to ft.,	From ft. to ft.

6	GROUT MATERIAL:		1 Neat cement	2 Cement grout	3 Bentonite	4 Other
	Grout Intervals:	From	25	ft. to	5	ft.
		From		ft. to		ft.

What is the nearest source of possible contamination:			<u>10 Livestock pens</u>	14 Abandoned water well
1 Septic tank	4 Lateral lines	7 Pit privy	11 Fuel storage	15 Oil well/Gas well
2 Sewer lines	5 Cess pool	8 Sewage lagoon	12 Fertilizer storage	16 Other (specify below)
3 Watertight sewer lines	6 Seepage pit	9 Feedyard	13 Insecticide storage	

Direction from well? West How many feet? 75-100

[illegible]

7 CONTRACTOR'S OR LANDOWNER'S CERTIFICATION: This water well was (1) constructed, (2) reconstructed, or (3) plugged under my jurisdiction and was completed on (mo/day/year) 9-15-93 and this record is true to the best of my knowledge and belief. Kansas Water Well Contractor's License No. 398 This Water Well Record was completed on (mo/day/yr) 9-21-93 under the business name of Kelley Drilling Co. by (signature) Richard P. Kelley

INSTRUCTIONS: Use typewriter or ball point pen. PLEASE PRESS FIRMLY and PRINT clearly. Please fill in blanks, underline or circle the correct answers. Send top three copies to Kansas Department of Health and Environment, Bureau of Water, Topeka, Kansas 66620-0001. Telephone: 913-296-5545. Send one to WATER WELL OWNER and retain one for your records.