


12mi. SW of Oberlin

RR#, St. Address, Box # : Gay Bryan
City, State, ZIP Code : 710 East Ash Oberlin, Kan 67749

Application Number:

4 DEPTH OF COMPLETED WELL... 30 ft. ELEVATION:

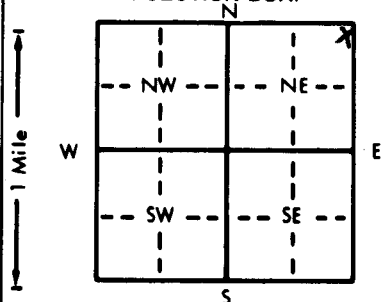

Depth(s) Groundwater Encountered 1. 15 ft. 2. _____ ft. 3. _____ ft.

WELL'S STATIC WATER LEVEL 15 ... ft. below land surface measured on mo/day/yr

Pump test data: Well water was ft. after hours pumping gpm

Est. Yield . . . 5 . . . gpm: Well water was . . . ft. after . . . hours pumping . . . gpm

Bore Hole Diameter . 8 in. to ft. and in. to ft.

WELL WATER TO BE USED AS: 5 Public water supply 8 Air conditioning 11 Injection well

1 Domestic	3 Feedlot	6 Oil field water supply	9 Dewatering	12 Other (Specify below)
------------	-----------	--------------------------	--------------	--------------------------

2 Irrigation 4 Industrial 7 Lawn and garden only 10 Observation well

Was a chemical/bacteriological sample submitted to Department? Yes ☐ No ☒ : If yes, mg/day/yr sample was sub

Was a chemical/bacteriological sample submitted to Department? Yes.....No....., if yes, the day/yr sample was submitted

Water Well Disinfected? Yes ☒ No

Water Well Disinfected? Yes ☒ No ☐

5 Wrought iron	8 Concrete tile	CASING JOINTS: Glued	☒ Clamped
----------------	-----------------	----------------------	---

1 Steel	3 RMP (SR)	6 Asbestos-Cement	9 Other (specify below)	Welded
---------	------------	-------------------	-------------------------	--------

2 PVC 4 ABS 7 Fiberglass Welded Threaded

Blank casing diameter 5 in. to 25 ft. Dia. in. to ft. Dia. in. to ft. Dia.

Casing height above land surface 12 in. weight lbs./ft. Wall thickness or gauge No. 258

TYPE OF SCREEN OR PERFORATION MATERIAL : 3 PVC 10 Asbestos cement

7 PVC
8 RMP (SR)
9 Asbestos-cement
10 Other (specify):

1 Steel	3 Stainless steel	5 Fiberglass	8 HMP (SH)	11 Other (specify)
2 Brass	4 Galvanized steel	6 Concrete tile	9 ABS	10 None used (open hole)

2 Brass 4 Galvanized steel 6 Concrete tile 9 ABS 12 None used (open hole)

TEEN OR PERFORATION OPENINGS ARE: 5 Gauzed wrapped 8 Saw cut 11 None (open hole)

1 Continuous slot	3 Mill slot	5 Gauzed wrapped	8 Saw cut	11 None (open hole)
		6 Wire wrapped	9 Drilled holes	

1 Continuous slot	3 Mill slot	6 Wire wrapped	9 Drilled holes
2 Louvered shutter	4 Key punched	7 Taper cut	10 Other (specify)

2 Louvered shutter 4 Key punched 7 Torch cut 10 Other (specify)

FEEN PERFORATED INTERVALS: From 00 10 to 02 10 to 05 10 to 08

SCREEN-PERFORATED INTERVALS: From 30 ft. to 25 ft., From ft. to ft.
From ft. to ft.

From ft. to ft., From ft. to ft.

GRAVEL PACK INTERVALS: From: . . . 30 ft. to . . . 20 ft., From ft. to ft.

From _____ ft. to _____ ft., From _____ ft. to _____ ft.

6] GROUT MATERIAL: 1 Neat cement 2 Cement grout 3 Bentonite 4 Other

Grout Intervals: From 20 ft. to 0 ft., From ft. to ft., From ft. to ft.

What is the nearest source of possible contamination: 10 Livestock pens 14 Abandoned water well

1 Septic tank	4 Lateral lines	7 Pit privy	11 Fuel storage	15 Oil well/Gas well
---------------	-----------------	-------------	-----------------	----------------------

2 Sewer lines 5 Cess pool 8 Sewage lagoon 12 Fertilizer storage 16 Other (specify below)

3 Watertight sewer lines 6 Seepage pit 9 Feedyard 13 Insecticide storage none.....

Direction from well?						How many feet?					

TO	
----	--

[illegible]

7 **CONTRACTOR'S OR LANDOWNER'S CERTIFICATION:** This water well was (1) constructed, (2) reconstructed, or (3) plugged under my jurisdiction and was

completed on (mo/day/year) 7-14-89 and this record is true to the best of my knowledge and belief. Kansas

Water Well Contractor's License No. 398 This Water Well Record was completed on (mo/day/yr) 8-10-89

under the business name of **Kelley Drilling Co.** by (signature) *Richard A. Kelley*

INSTRUCTIONS: Use typewriter or ball point pen. PLEASE PRESS FIRMLY and PRINT clearly. Please fill in blanks, underline or circle the correct answers. Send top three copies to Kansas

Department of Health and Environment, Office of Oil Field and Environmental Geology, Regulation and Permitting Section, Topeka, Kansas 66620-7500, Telephone: 913-862-9360. Send one to WATER WELL OWNER and retain one for your records.

to WATER WELL OWNER and retain one for your records.