

USE TYPEWRITER OR BALL POINT PEN-PRESS FIRMLY, PRINT CLEARLY.


WATER WELL RECORD
KSA 82a-1201-1215

Kansas Department of Health and Environment-Division of Environment
(Water well Contractors)
Topeka, Kansas 66620

AAA

1. Location of well: County Decatur Fraction NE 1/4 NE 1/4 NE 1/4 Section number 35 Township number T 4 S R 30 E Range number 30

2. Distance and direction from nearest town or city: 8N-SE Selden 3. Owner of well: Albert Koehler
Street address of well location if in city: R.R. or street: _____
City, state, zip code: Selden, Kansas

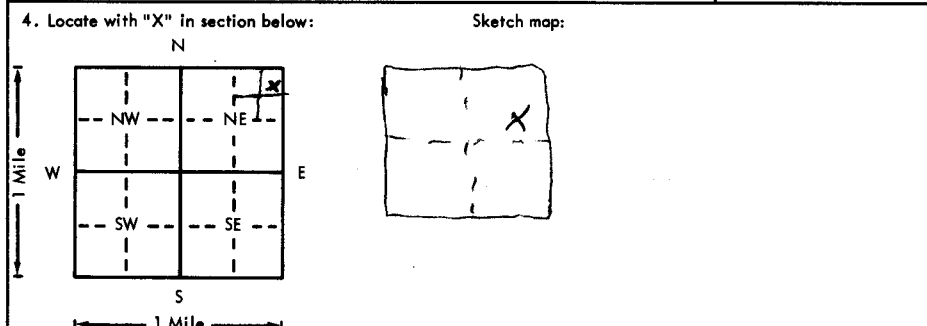

6. Bore hole dia. 3 in. Completion date 4/17/75
Well depth 131 ft.

7. Cable tool Rotary Driven Dug
 Hollow rod Jetted Bored Reverse rotary

8. Use: Domestic Public supply Industry
 Irrigation Air conditioning Stock
 Lawn Oil field water Other

9. Casing: Material RMP Height Above or below
Threaded Welded Surface 6 in.
RMP PVC Weight 4.81 lbs./ft.
Dia. 5 in. to 111 ft. depth Wall thickness: inches or
Dia. 5 in. to 111 ft. depth gage No. 250

5. Type and color of material	From	To
Top soil	0	95
sand	95	97
sandy clay	97	105
sand	105	111
sandy clay	111	118
sandy clay	118	122
sand	122	131
shale	131	

10. Screen: Manufacturer's name Jess Howell Superior
Type RMP Dia. 5 1/2"
Slot/gauze 1/32 Length 20'
Set between 111 ft. and 131 ft.
Gravel pack? Size range of material 1/32

11. Static water level: 98 ft. below land surface Date 11/15/75 mo./day/yr.

12. Pumping level below land surface: Not tested
____ ft. after ____ hrs. pumping ____ g.p.m.
____ ft. after ____ hrs. pumping ____ g.p.m.
Estimated maximum yield ____ g.p.m.

13. Water sample submitted: ____ mo./day/yr.
Yes No Date _____

14. Well head completion: 6 inches above grade
 Pitless adapter

15. Well grouted? Yes clay
With: Neat cement Bentonite Concrete
Depth: From 0 ft. to 17 ft.

16. Nearest source of possible contamination: 150 ft. Direction E Type Ditch
Well disinfected upon completion? Yes No

17. Pump: Not installed
Manufacturer's name _____ HP _____ Volts _____
Length of drop pipe _____ ft. capacity _____ g.p.m.
Type: Submersible Turbine
 Jet Reciprocating
 Centrifugal Other

18. Elevation: _____

19. Remarks: 2825 (TOPO) cement 1 1/2
clay 15
cement 3

Topography: _____
 Hill
 Slope
 Upland
 Valley

20. Water well contractor's certification:
This well was drilled under my jurisdiction and this report is true to the best of my knowledge and belief.
Cordes Drilling 114
Business name Selden, KS License No. _____
Address Selden, KS
Signed Elmer Cordy Date 12-10-78
Authorized representative

T 4
R 30
E 30
SW 1/4
SE 1/4