


WATER WELL RECORD Form WWC-5 KSA 82a-1212

1 LOCATION OF WATER WELL: County: Rawlins	Fraction SW 1/4 SW 1/4 NW 1/4	Section Number 15	Township Number T 4 S	Range Number R 31 EW
---	---	-----------------------------	---------------------------------	--------------------------------

Distance and direction from nearest town or city street address of well if located within city?
land 3/4 mi east and 1/2 mi. south of Achilles, Kansas

2 WATER WELL OWNER: **Kevin Holle**
 RR#, St. Address, Box # : **Rt. 2**
 City, State, ZIP Code : **Oberlin, Kansas 67749**
 Board of Agriculture, Division of Water Resources
 Application Number:

3 LOCATE WELL'S LOCATION WITH AN "X" IN SECTION BOX:

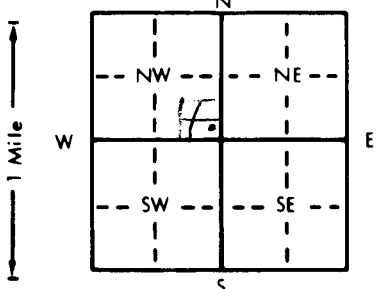

4 DEPTH OF COMPLETED WELL **122** ft. ELEVATION:
 Depth(s) Groundwater Encountered 1. **114** ft. 2. ft. 3. ft.
 WELL'S STATIC WATER LEVEL **114** ft. below land surface measured on mo/day/yr
 Pump test data: Well water was ft. after hours pumping gpm
 Est. Yield **3** gpm: Well water was ft. after hours pumping gpm
 Bore Hole Diameter **7** in. to ft., and in. to ft.
 WELL WATER TO BE USED AS:
 1 Domestic 3 Feedlot 6 Oil field water supply 9 Dewatering 12 Other (Specify below)
 2 Irrigation 4 Industrial 7 Lawn and garden only 10 Monitoring well
 Was a chemical/bacteriological sample submitted to Department? Yes No X; If yes, mo/day/yr sample was submitted
 Water Well Disinfected? Yes X No

5 TYPE OF BLANK CASING USED:
 1 Steel 3 RMP (SR) 5 Wrought iron 8 Concrete tile CASING JOINTS: Glued X Clamped
 2 PVC 4 ABS 6 Asbestos-Cement 9 Other (specify below) Welded
 7 Fiberglass Threaded
 Blank casing diameter **4** in. to **102** ft., Dia in. to ft., Dia in. to ft.
 Casing height above land surface **12** in., weight lbs./ft. Wall thickness or gauge No. **214**
 TYPE OF SCREEN OR PERFORATION MATERIAL:
 1 Steel 3 Stainless steel 5 Fiberglass 8 RMP (SR) 11 Other (specify)
 2 Brass 4 Galvanized steel 6 Concrete tile 9 ABS 12 None used (open hole)
 SCREEN OR PERFORATION OPENINGS ARE:
 1 Continuous slot 3 Mill slot 5 Gauzed wrapped ~~8 Saw cut~~ 11 None (open hole)
 2 Louvered shutter 4 Key punched 6 Wire wrapped 9 Drilled holes
 7 Torch cut 10 Other (specify)
 SCREEN-PERFORATED INTERVALS: From **122** ft. to **102** ft., From ft. to ft.
 GRAVEL PACK INTERVALS: From **122** ft. to **20** ft., From ft. to ft.

6 GROUT MATERIAL: 1 Neat cement 2 Cement grout 3 Bentonite 4 Other
 Grout Intervals: From **20** ft. to **0** ft., From ft. to ft., From ft. to ft.
 What is the nearest source of possible contamination:
 1 Septic tank 4 Lateral lines 7 Pit privy 10 Livestock pens 14 Abandoned water well
 2 Sewer lines 5 Cess pool 8 Sewage lagoon 11 Fuel storage 15 Oil well/Gas well
 3 Watertight sewer lines 6 Seepage pit 9 Feedyard 12 Fertilizer storage 16 Other (specify below)
 13 Insecticide storage **None**
 Direction from well? How many feet?

FROM	TO	LITHOLOGIC LOG	FROM	TO	PLUGGING INTERVALS
0	3	Top			
3	35	clay			
35	65	limstone			
65	80	fine sand			
80	90	clay			
90	105	limstone			
105	110	fine sand			
110	119	sand			
119		shale			

7 CONTRACTOR'S OR LANDOWNER'S CERTIFICATION: This water well was (1) constructed, (2) reconstructed, or (3) plugged under my jurisdiction and was completed on (mo/day/year) **3-21-97** and this record is true to the best of my knowledge and belief. Kansas Water Well Contractor's License No. **398** This Water Well Record was completed on (mo/day/yr) **3-29-97** under the business name of **Kelley Drilling Co.** by (signature) *Richard Kelley*