


1 LOCATION OF WATER WELL: County: Rawlins Fraction: SW 1/4 NE 1/4 Section Number: 26 Township Number: T 4 S Range Number: R 31 E/W

Distance and direction from nearest town or city street address of well if located within city?
About 15 North of Rexford, Kansas

2 WATER WELL OWNER: RR#, St. Address, Box #: Jim Gilbert Board of Agriculture, Division of Water Resources
 City, State, ZIP Code: Gem, Kansas 67734 Application Number:

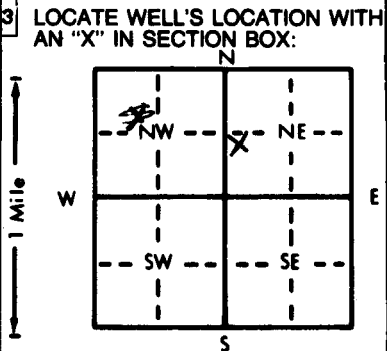

4 DEPTH OF COMPLETED WELL: 126 ft. ELEVATION:ft.
 Depth(s) Groundwater Encountered 1. 110 ft. 2.ft. 3.ft.
 WELL'S STATIC WATER LEVEL: 110 ft. below land surface measured on mo/day/yrft.
 Pump test data: Well water wasft. after hours pumping gpm
 Est. Yield: 4 gpm; Well water wasft. after hours pumping gpm
 Bore Hole Diameter: 8 in. toft., andin. toft.
 WELL WATER TO BE USED AS:
 5 Public water supply 8 Air conditioning 11 Injection well
 1 Domestic 3 Feedlot 6 Oil field water supply 9 Dewatering 12 Other (Specify below)
 2 Irrigation 4 Industrial 7 Lawn and garden only 10 Observation well
 Was a chemical/bacteriological sample submitted to Department? Yes.....No...X.....; If yes, mo/day/yr sample was submitted
 Water Well Disinfected? Yes No X

5 TYPE OF BLANK CASING USED:
 1 Steel 3 RMP (SR) 5 Wrought iron 8 Concrete tile CASING JOINTS: Glued...X...Clamped.....
 2 PVC 4 ABS 6 Asbestos-Cement 9 Other (specify below) Welded.....
 7 Fiberglass Threaded.....
 Blank casing diameter: 5 in. to 116 ft., Diain. toft., Diain. toft.
 Casing height above land surface: 12 in., weight lbs./ft. Wall thickness or gauge No. 214
 TYPE OF SCREEN OR PERFORATION MATERIAL:
 1 Steel 3 Stainless steel 5 Fiberglass 7 PVC 10 Asbestos-cement
 2 Brass 4 Galvanized steel 6 Concrete tile 8 RMP (SR) 11 Other (specify)
 12 None used (open hole)
 SCREEN OR PERFORATION OPENINGS ARE:
 1 Continuous slot 3 Mill slot 5 Gauzed wrapped 8 Saw cut 11 None (open hole)
 2 Louvered shutter 4 Key punched 6 Wire wrapped 9 Drilled holes
 7 Torch cut 10 Other (specify)
 SCREEN-PERFORATED INTERVALS: From 126-116 ft. to 116-126 ft., Fromft. toft.
 Fromft. toft., Fromft. toft.
 GRAVEL PACK INTERVALS: From 126 ft. to 10 ft., Fromft. toft.
 Fromft. toft., Fromft. toft.

6 GROUT MATERIAL: 1 Neat cement 2 Cement grout 3 Bentonite 4 Other
 Grout Intervals: From 10 ft. to 0 ft., Fromft. toft., Fromft. toft.
 What is the nearest source of possible contamination:
 1 Septic tank 4 Lateral lines 7 Pit privy 10 Livestock pens 14 Abandoned water well
 2 Sewer lines 5 Cess pool 8 Sewage lagoon 11 Fuel storage 15 Oil well/Gas well
 3 Watertight sewer lines 6 Seepage pit 9 Feedyard 12 Fertilizer storage 16 Other (specify below)
 13 Insecticide storage none pasture
 Direction from well? How many feet?

FROM	TO	LITHOLOGIC LOG	FROM	TO	LITHOLOGIC LOG
0	43	Top			
43	47	sand dry			
47	55	clay			
55	57	sand			
57	82	clay			
82	88	fine sand			
88	90	clay			
90	120	fine sand			
120	126	sand			
126		shale			

7 CONTRACTOR'S OR LANDOWNER'S CERTIFICATION: This water well was (1) constructed, (2) reconstructed, or (3) plugged under my jurisdiction and was completed on (mo/day/year) 10-16-86 and this record is true to the best of my knowledge and belief. Kansas Water Well Contractor's License No. 398. This Water Well Record was completed on (mo/day/yr) 12-16-86 under the business name of Kelley Drilling Co. by (signature) Richard O. Kelley

INSTRUCTIONS: Use typewriter or ball point pen. PLEASE PRESS FIRMLY and PRINT clearly. Please fill in blanks, underline or circle the correct answers. Send top three copies to Kansas Department of Health and Environment, Office of Oil Field and Environmental Geology, Regulation and Permitting Section, Topeka, Kansas 66620-7500, Telephone: 913-862-9360. Send one to WATER WELL OWNER and retain one for your records.