




WATER WELL RECORD Form WWC-5 1235447

Division of Water Resources App. No. [ ] Well ID [ ]

Original Record Correction Change in Well Use

Table with 5 columns: 1 LOCATION OF WATER WELL: County; Fraction (1/4, 1/4, 1/4, 1/4); Section Number; Township Number (T, S); Range Number (R, E, W).

2 WELL OWNER: Last Name, First, Street or Rural Address where well is located (if unknown, distance and direction from nearest town or intersection): If at owner's address, check here: [ ]

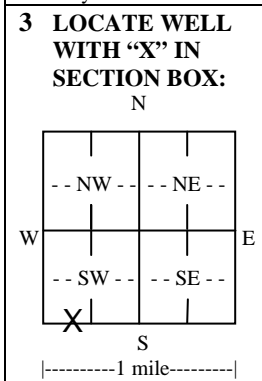

4 DEPTH OF COMPLETED WELL: Depth(s) Groundwater Encountered: 1) ... ft. 2) ... ft. 3) ... ft., or 4) [ ] Dry Well. WELL'S STATIC WATER LEVEL: ... ft. [ ] below land surface, measured on (mo-day-yr) ... [ ] above land surface, measured on (mo-day-yr) ... Pump test data: Well water was ... ft. after ... hours pumping ... gpm. Well water was ... ft. after ... hours pumping ... gpm. Estimated Yield: ... gpm. Bore Hole Diameter: ... in. to ... ft. and ... in. to ... ft.

5 Latitude: ... (decimal degrees) Longitude: ... (decimal degrees) Datum: [ ] WGS 84 [ ] NAD 83 [ ] NAD 27 Source for Latitude/Longitude: [ ] GPS (unit make/model: ...) (WAAS enabled? [ ] Yes [ ] No) [ ] Land Survey [ ] Topographic Map [ ] Online Mapper: ...

6 Elevation: ... ft. [ ] Ground Level [ ] TOC Source: [ ] Land Survey [ ] GPS [ ] Topographic Map [ ] Other ...

7 WELL WATER TO BE USED AS: 1. Domestic: [ ] Household [ ] Lawn & Garden [ ] Livestock 2. [ ] Irrigation 3. [ ] Feedlot 4. [ ] Industrial 5. [ ] Public Water Supply: well ID ... 6. [ ] Dewatering: how many wells? ... 7. [ ] Aquifer Recharge: well ID ... 8. [ ] Monitoring: well ID ... 9. Environmental Remediation: well ID ... [ ] Air Sparge [ ] Soil Vapor Extraction [ ] Recovery [ ] Injection 10. [ ] Oil Field Water Supply: lease ... 11. Test Hole: well ID ... [ ] Cased [ ] Uncased [ ] Geotechnical 12. Geothermal: how many bores? ... a) Closed Loop [ ] Horizontal [ ] Vertical b) Open Loop [ ] Surface Discharge [ ] Inj. of Water 13. [ ] Other (specify): ...

Was a chemical/bacteriological sample submitted to KDHE? [ ] Yes [ ] No If yes, date sample was submitted: ... Water well disinfected? [ ] Yes [ ] No

8 TYPE OF CASING USED: [ ] Steel [ ] PVC [ ] Other ... CASING JOINTS: [ ] Glued [ ] Clamped [ ] Welded [ ] Threaded Casing diameter ... in. to ... ft., Diameter ... in. to ... ft., Diameter ... in. to ... ft. Casing height above land surface ... in. Weight ... lbs./ft. Wall thickness or gauge No. ... TYPE OF SCREEN OR PERFORATION MATERIAL: [ ] Steel [ ] Stainless Steel [ ] Fiberglass [ ] PVC [ ] Other (Specify) ... [ ] Brass [ ] Galvanized Steel [ ] Concrete tile [ ] None used (open hole) SCREEN OR PERFORATION OPENINGS ARE: [ ] Continuous Slot [ ] Mill Slot [ ] Gauze Wrapped [ ] Torch Cut [ ] Drilled Holes [ ] Other (Specify) ... [ ] Louvered Shutter [ ] Key Punched [ ] Wire Wrapped [ ] Saw Cut [ ] None (Open Hole) SCREEN-PERFORATED INTERVALS: From ... ft. to ... ft., From ... ft. to ... ft., From ... ft. to ... ft. GRAVEL PACK INTERVALS: From ... ft. to ... ft., From ... ft. to ... ft., From ... ft. to ... ft.

9 GROUT MATERIAL: [ ] Neat cement [ ] Cement grout [ ] Bentonite [ ] Other ... Grout Intervals: From ... ft. to ... ft., From ... ft. to ... ft., From ... ft. to ... ft. Nearest source of possible contamination: [ ] Septic Tank [ ] Lateral Lines [ ] Pit Privy [ ] Livestock Pens [ ] Insecticide Storage [ ] Sewer Lines [ ] Cess Pool [ ] Sewage Lagoon [ ] Fuel Storage [ ] Abandoned Water Well [ ] Watertight Sewer Lines [ ] Seepage Pit [ ] Feedyard [ ] Fertilizer Storage [ ] Oil Well/Gas Well [ ] Other (Specify) ... Direction from well? ... Distance from well? ... ft.

10 FROM TO LITHOLOGIC LOG FROM TO LITHO. LOG (cont.) or PLUGGING INTERVALS. A table with 6 columns for logging data.

Notes:

11 CONTRACTOR'S OR LANDOWNER'S CERTIFICATION: This water well was [ ] constructed, [ ] reconstructed, or [ ] plugged under my jurisdiction and was completed on (mo-day-year) ... and this record is true to the best of my knowledge and belief. Kansas Water Well Contractor's License No. ... This Water Well Record was completed on (mo-day-year) ... under the business name of ...