


1 LOCATION OF WATER WELL: County: Rawlins Fraction: NW  $\frac{1}{4}$   $\frac{1}{4}$   $\frac{1}{4}$  Section Number: 30 Township Number: T 4 S Range Number: R 33 EW

Distance and direction from nearest town or city street address of well if located within city?  
10 miles so Atwood

2 WATER WELL OWNER: Wilbur Brown  
RR#, St. Address, Box #: RR1 Box 61 Board of Agriculture, Division of Water Resources  
City, State, ZIP Code: Atwood Ks Application Number:

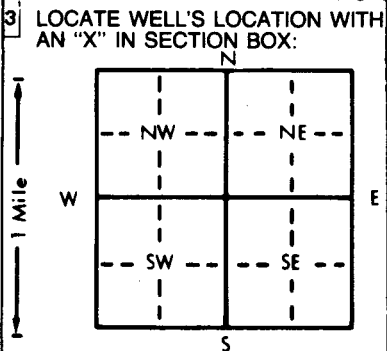

4 DEPTH OF COMPLETED WELL: 236 ft. ELEVATION: .....  
Depth(s) Groundwater Encountered 1. 104 ft. 2. .... ft. 3. .... ft.  
WELL'S STATIC WATER LEVEL: 132 ft. below land surface measured on mo/day/yr 3-11-96  
Pump test data: Well water was 185 ft. after 2 hours pumping 20 gpm  
Est. Yield 20 gpm: Well water was ..... ft. after ..... hours pumping ..... gpm  
Bore Hole Diameter: ..... in. to ..... ft., and ..... in. to ..... ft.  
WELL WATER TO BE USED AS:  
5 Public water supply 8 Air conditioning 11 Injection well  
1 Domestic 3 Feedlot 6 Oil field water supply 9 Dewatering 12 Other (Specify below)  
2 Irrigation 4 Industrial 7 Lawn and garden only 10 Monitoring well  
Was a chemical/bacteriological sample submitted to Department? Yes.....No X.....; If yes, mo/day/yr sample was submitted  
Water Well Disinfected? Yes X No

5 TYPE OF BLANK CASING USED:  
1 Steel 3 RMP (SR) 5 Wrought iron 8 Concrete tile CASING JOINTS: Glued Clamped .....  
2 PVC 4 ABS 6 Asbestos-Cement 9 Other (specify below) Welded .....  
7 Fiberglass Threaded .....  
Blank casing diameter ..... in. to ..... ft., Dia ..... in. to ..... ft., Dia ..... in. to ..... ft.  
Casing height above land surface: 12 in., weight SDR21 lbs./ft. Wall thickness or gauge No. ....  
TYPE OF SCREEN OR PERFORATION MATERIAL:  
1 Steel 3 Stainless steel 5 Fiberglass 7 PVC 10 Asbestos-cement  
2 Brass 4 Galvanized steel 6 Concrete tile 8 RMP (SR) 11 Other (specify) .....  
9 ABS 12 None used (open hole)  
SCREEN OR PERFORATION OPENINGS ARE: .016  
1 Continuous slot 3 Mill slot 5 Gauzed wrapped 8 Saw cut 11 None (open hole)  
2 Louvered shutter 4 Key punched 6 Wire wrapped 9 Drilled holes  
7 Torch cut 10 Other (specify) .....  
SCREEN-PERFORATED INTERVALS: From 216 ft. to 236 ft., From ..... ft. to ..... ft.  
From ..... ft. to ..... ft., From ..... ft. to ..... ft.  
GRAVEL PACK INTERVALS: From 30 ft. to 236 ft., From ..... ft. to ..... ft.  
From ..... ft. to ..... ft., From ..... ft. to ..... ft.

6 GROUT MATERIAL: 1 Neat cement 2 Cement grout 3 Bentonite 4 Other .....  
Grout Intervals: From 5 ft. to 30 ft., From ..... ft. to ..... ft., From ..... ft. to ..... ft.  
What is the nearest source of possible contamination:  
1 Septic tank 4 Lateral lines 7 Pit privy 10 Livestock pens 14 Abandoned water well  
2 Sewer lines 5 Cess pool 8 Sewage lagoon 11 Fuel storage 15 Oil well/Gas well  
3 Watertight sewer lines 6 Seepage pit 9 Feedyard 12 Fertilizer storage 16 Other (specify below)  
13 Insecticide storage  
Direction from well? How many feet?

FROM	TO	LITHOLOGIC LOG	FROM	TO	PLUGGING INTERVALS
0	100	clay			
100	144	clay + mag			
144	162	med gr			
162	187	clay + gr			
187	221	gr fair			
221	231	med gr			
231	236	shale			

7 CONTRACTOR'S OR LANDOWNER'S CERTIFICATION: This water well was (1) constructed, (2) reconstructed, or (3) plugged under my jurisdiction and was completed on (mo/day/year) 2-29-96 and this record is true to the best of my knowledge and belief. Kansas Water Well Contractor's License No. 286 This Water Well Record was completed on (mo/day/yr) 3-12-96 under the business name of Wilcox Drilling by (signature) Bob Wilcox