


USE TYPEWRITER OR BALL POINT PEN—PRESS FIRMLY, PRINT CLEARLY.

WATER WELL RECORD
KSA 82a-1201-1215

Kansas Department of Health and Environment—Division of Environment (Water well Contractors)
Topeka, Kansas 66620

1. Location of well: County Rawlins Fraction SW 1/4 SW 1/4 NW 1/4 Section number 19 Township number T 4 S Range number R 23 E 2

Distance and direction from nearest town or city: 6 Miles S, 1 W 1 1/2 S
Street address of well location if in city: ATwood, KS
3. Owner of well: Pyle Bowler
R.R. or street: Atwood, R2 67730
City, state, zip code:

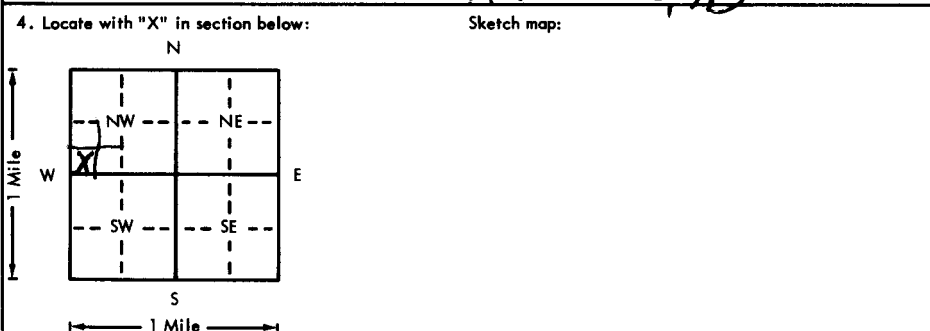

6. Bore hole dia. 30 in. Completion date 2-5-78
Well depth 163 ft.
7. Cable tool Rotary Driven Dug
 Hollow rod Jetted Bored Reverse rotary
8. Use: Domestic Public supply Industry
 Irrigation Air conditioning Stock
 Lawn Oil field water Other
9. Casing: Material Steel Height: Above or below
Threaded Welded Surface 12 in.
RMP PVC Weight 32 lbs./ft.
Dia. 16 in. to 163 ft. depth Wall Thickness: inches or
Dia. 16 in. to 163 ft. depth gage No. 7

5. Type and color of material	From	To
<u>top soil - clay</u>	<u>0</u>	<u>80</u>
<u>5' loose porous rock</u>	<u>80</u>	<u>90</u>
<u>10' loose porous rock</u>	<u>90</u>	<u>100</u>
<u>6' loose porous rock 4' clay little ^{rock} _{gravel}</u>	<u>100</u>	<u>110</u>
<u>10' loose porous rock</u>	<u>110</u>	<u>130</u>
<u>10' clay</u>	<u>130</u>	<u>140</u>
<u>10' clay</u>	<u>140</u>	<u>150</u>
<u>10' sand & gravel</u>	<u>150</u>	<u>160</u>
<u>10' gravel</u>	<u>150</u>	<u>160</u>
<u>3' shale</u>	<u>160</u>	<u>163</u>

10. Screen: Manufacturer's name W.G. Brown Enterprises
Type face flow Dia. 16"
Slot gauze 3/16 Length 40'
Set between 123 ft. and 163 ft.
_____ ft. and _____ ft.
Gravel pack? Size range of material 3/4
11. Static water level: _____ ft. below land surface Date 3-5-78 mg./day/yr.
12. Pumping level below land surfaces:
_____ ft. after _____ hrs. pumping _____ g.p.m.
150 ft. after 4 hrs. pumping 400 g.p.m.
Estimated maximum yield 400 g.p.m.
13. Water sample submitted: _____ mo./day/yr.
 Yes No Date _____
14. Well head completion:
 Pitless adapter _____ Inches above grade
15. Well grouted? Buddled Clay
With: Neat cement Bentonite Concrete
Depth: From 0 ft. to 10 ft.
16. Nearest source of possible contamination:
ft. _____ Direction _____ Type _____
Well disinfected upon completion? Yes No
17. Pump: Not installed
Manufacturer's name Western Land Pumps
Model number 600-30 HP 30 Volts 460
Length of drop pipe 158 ft. capacity 400 g.p.m.
Type:
 Submersible Turbine
 Jet Reciprocating
 Centrifugal Other

18. Elevation: _____
19. Remarks: irrigation gated pipe

20. Water well contractor's certification:
This well was drilled under my jurisdiction and this report is true to the best of my knowledge and belief.
Jack Bone Business name License No. _____
Address McDonald R2 67745
Signed Jack Bone Date 5-9-78
Authorized representative

4
 33
 19
 SW 1/4 NW 1/4
 Sec 19