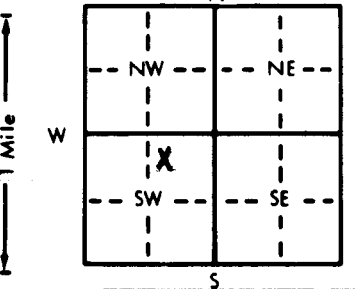


1 LOCATION OF WATER WELL: County: Rawlins Fraction: NW 1/4 NE 1/4 SW 1/4 Section Number: 23 Township Number: T 4 S Range Number: R 33 EW

Distance and direction from nearest town or city street address of well if located within city?  
8 1/2 mile Southeast of Atwood

2 WATER WELL OWNER: Rola Morgan  
 RR#, St. Address, Box #: 650 Lake Road  
 City, State, ZIP Code: Atwood KS 67730  
 Board of Agriculture, Division of Water Resources  
 Application Number:

3 LOCATE WELL'S LOCATION WITH AN "X" IN SECTION BOX:  


4 DEPTH OF COMPLETED WELL: 75 ft. ELEVATION: 3000 FT  
 Depth(s) Groundwater Encountered 1. .... ft. 2. .... ft. 3. .... ft.  
 WELL'S STATIC WATER LEVEL: 54 ft. below land surface measured on mo/day/yr 9/19/88  
 Pump test data: Well water was ..... ft. after ..... hours pumping ..... gpm  
 Est. Yield ..... gpm: Well water was ..... ft. after ..... hours pumping ..... gpm  
 Bore Hole Diameter ..... in. to ..... ft., and ..... in. to ..... ft.  
 WELL WATER TO BE USED AS:  
 1 Domestic     3 Feedlot     6 Oil field water supply     9 Dewatering     12 Other (Specify below)  
 2 Irrigation     4 Industrial     7 Lawn and garden only     10 Monitoring well  
 Was a chemical/bacteriological sample submitted to Department? Yes.....No.....; If yes, mo/day/yr sample was sub-  
 mitted  
 Water Well Disinfected? Yes    No

5 TYPE OF BLANK CASING USED:  
 1 Steel 20jr     3 RMP (SR)  
 2 PVC     4 ABS  
 5 Wrought iron     8 Concrete tile    CASING JOINTS: Glued ..... Clamped .....  
 6 Asbestos-Cement     9 Other (specify below)    Welded .....  
 7 Fiberglass    Threaded.....  
 Blank casing diameter 5 in. to ..... ft., Dia ..... in. to ..... ft., Dia ..... in. to ..... ft.  
 Casing height above land surface ..... in., weight ..... lbs./ft. Wall thickness or gauge No. ....  
 TYPE OF SCREEN OR PERFORATION MATERIAL:  
 1 Steel     3 Stainless steel     5 Fiberglass     8 RMP (SR)     11 Other (specify) .....  
 2 Brass     4 Galvanized steel     6 Concrete tile     9 ABS     12 None used (open hole)  
 SCREEN OR PERFORATION OPENINGS ARE:  
 1 Continuous slot     3 Mill slot     5 Gauzed wrapped     8 Saw cut     11 None (open hole)  
 2 Louvered shutter     4 Key punched     6 Wire wrapped     9 Drilled holes  
 7 Torch cut     10 Other (specify) .....  
 SCREEN-PERFORATED INTERVALS: From ..... ft. to ..... ft., From ..... ft. to ..... ft.  
 From ..... ft. to ..... ft., From ..... ft. to ..... ft.  
 GRAVEL PACK INTERVALS: From ..... ft. to ..... ft., From ..... ft. to ..... ft.  
 From ..... ft. to ..... ft., From ..... ft. to ..... ft.

6 GROUT MATERIAL:  1 Neat cement     2 Cement grout     3 Bentonite     4 Other .....  
 Grout intervals: From ..... ft. to ..... ft., From ..... ft. to ..... ft., From ..... ft. to ..... ft.  
 What is the nearest source of possible contamination:  
 1 Septic tank     4 Lateral lines     7 Pit privy     10 Livestock pens     14 Abandoned water well  
 2 Sewer lines     5 Cess pool     8 Sewage lagoon     11 Fuel storage     15 Oil well/Gas well  
 3 Watertight sewer lines     6 Seepage pit     9 Feedyard     12 Fertilizer storage     16 Other (specify below)  
 13 Insecticide storage  
 Direction from well? How many feet?

FROM	TO	LITHOLOGIC LOG	FROM	TO	PLUGGING INTERVALS
					PLACED IN INACTIVE
					CAPPED TO CMD 4 SPEC'S

7 CONTRACTOR'S OR LANDOWNER'S CERTIFICATION: This water well was (1) constructed,  (2) reconstructed, or (3) plugged under my jurisdiction and was completed on (mo/day/year) Capped 9/19/88 and this record is true to the best of my knowledge and belief. Kansas Water Well Contractor's License No. .... This Water Well Record was completed on (mo/day/yr) ..... under the business name of Madsen's Well Service by (signature) Thayne Madsen